


T. 3 S., R. 12 E., W.M.

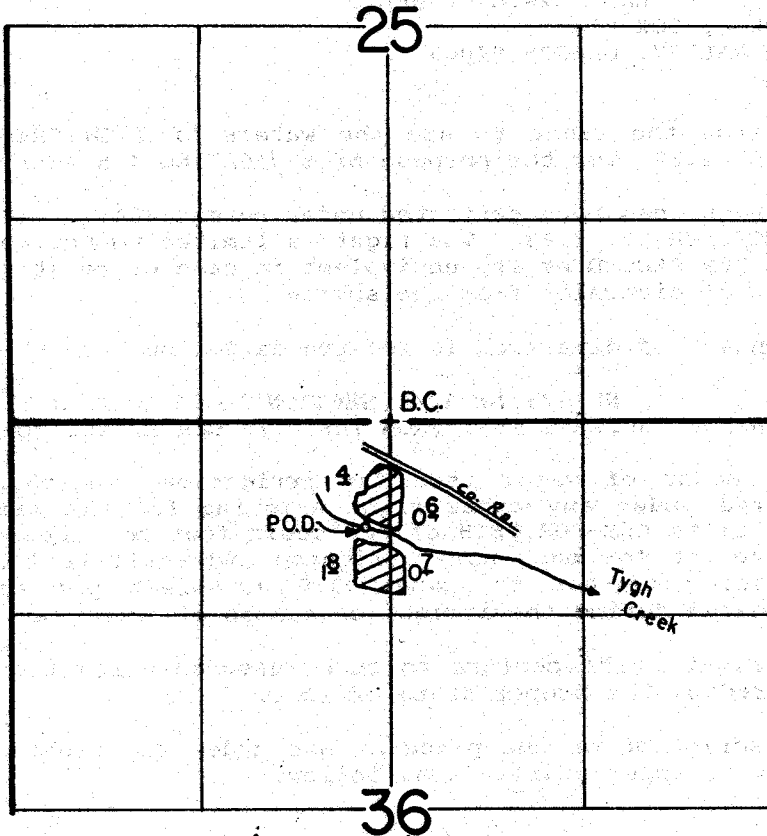

P.O.D. Loc. : 730' S. & 160' W. from N. 1/4 Cor., Sec. 36.

Scale : 1" = 1320'

**FINAL PROOF SURVEY**  
UNDER

Application No. 67545 Permit No. 48453  
IN NAME OF

RANDALL R. & PENNIE D. DELCO

Surveyed JUNE 8, 1988, by T. Warren