


T. 15 S., R. 6 W., W. M.  
Sec. 2

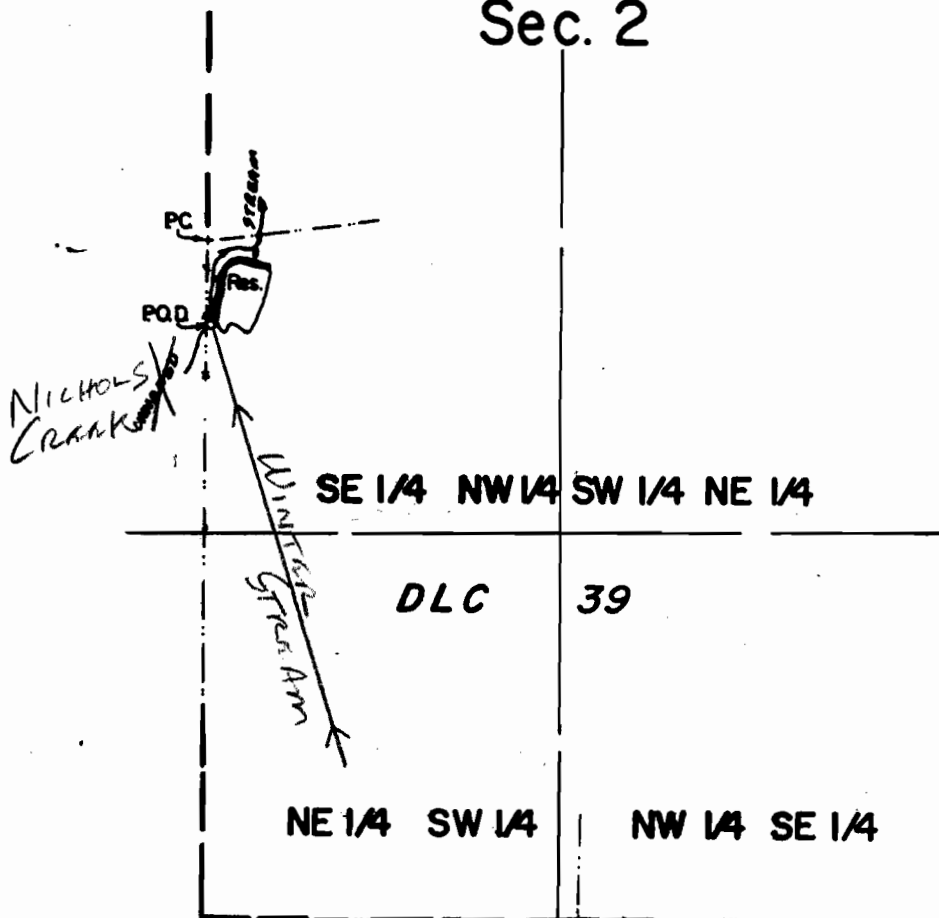

P.O.D. Loc.: 1230' N. & 10' E. from SW Cor. DLC 39.

Scale: 1" = 400'

**FINAL PROOF SURVEY**  
UNDER

R-67723 R-9400  
Application No. 67724 Permit No. 48280  
IN NAME OF

ANDREW J. SIMMONDS

Surveyed Nov. 18, 1987, by T. Warren

PTS. u/F.F.  
11/2/88 TMW