
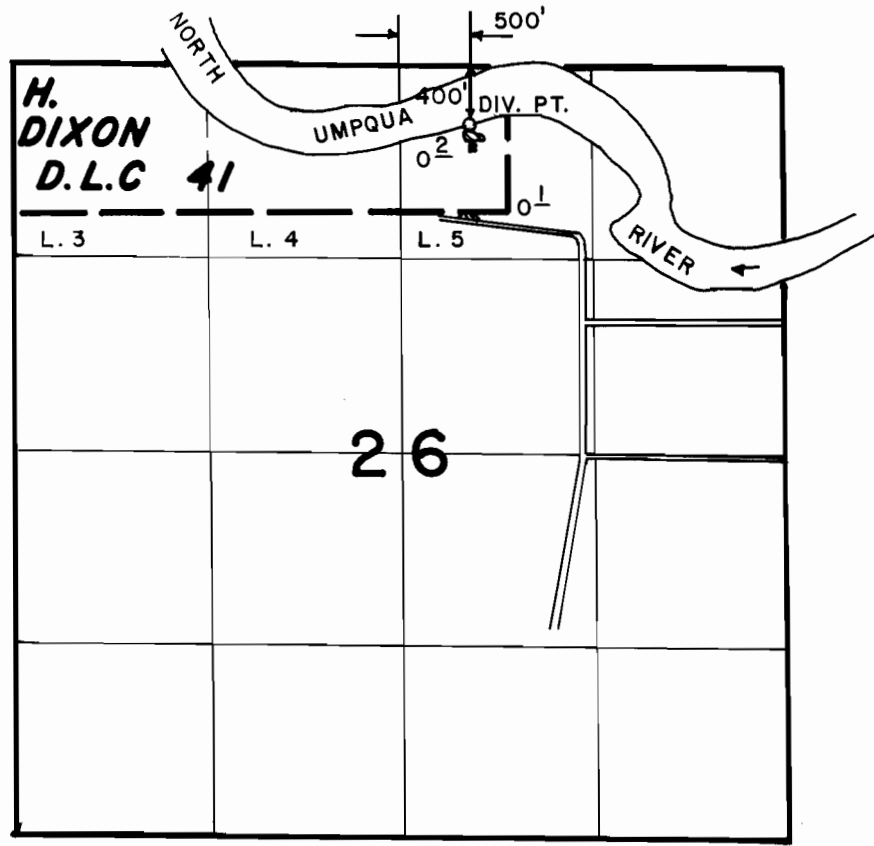


T. 26 S., R. 5 W., W.M.

SECTION 26

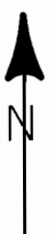

SCALE: 4" = 1 MILE

FINAL PROOF SURVEY UNDER

Application No. 67925 Permit No. 48224
IN NAME OF

LAWRENCE R. REDDING

Surveyed JULY 8 85
SEPT. 28 1988, by J.M. SCHMORDE