


T. 13 & 14 S., R. 32 E., W.M.

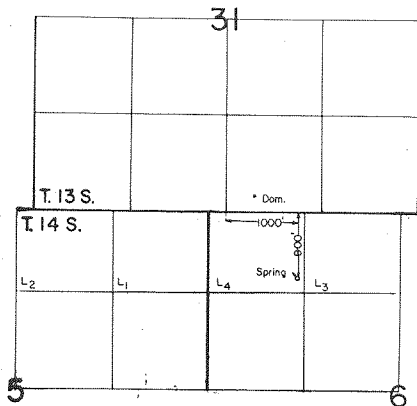

Scale: 1" = 1320'

FINAL PROOF SURVEY

UNDER

Application No. 67717, Permit No. 48210
IN NAME OF

ROBERT. D. & SHIRLEY M. BURNETT

Surveyed JULY 7, 1987, by VERN CHURCH.