


T. 11 S., R. 6 W., W.M.

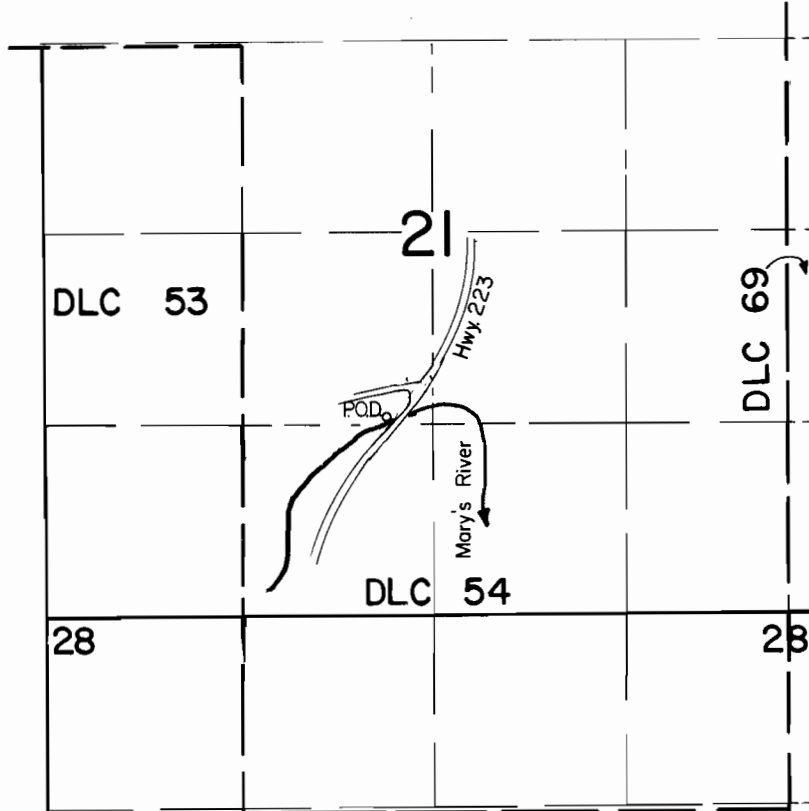

P.O.D. Loc. : 50' N. & 320' W. from SE Cor. NE 1/4 SW 1/4, Sec. 21.

Scale : 1" = 1320'

FINAL PROOF SURVEY
UNDER

Application No. 67970 Permit No. 48541
IN NAME OF

PHILOMATH RURAL FIRE DISTRICT 4

Surveyed May 18 1988, by T. Warren