


T. 1 & 2 N., R. 4 W., W. M.

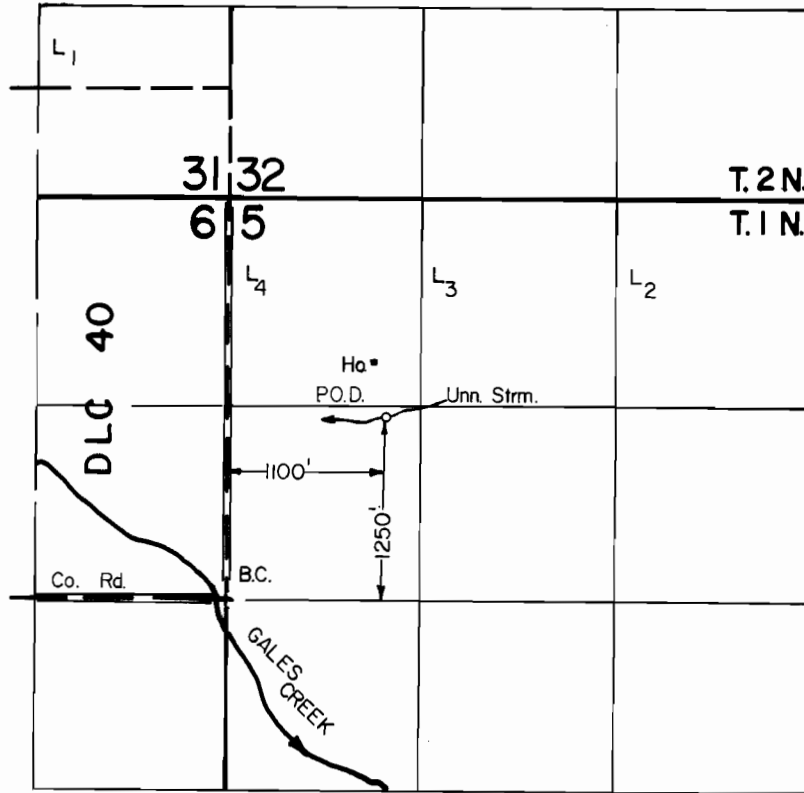

Scale : 1" = 1320'

FINAL PROOF SURVEY UNDER

Application No. 68057 Permit No. 48543.....

IN NAME OF

CALVIN CHARLES DAVIS.....

Surveyed AUG. 30. 1988., by T. Warren.....