


# T.26S., R.5W., W.M.

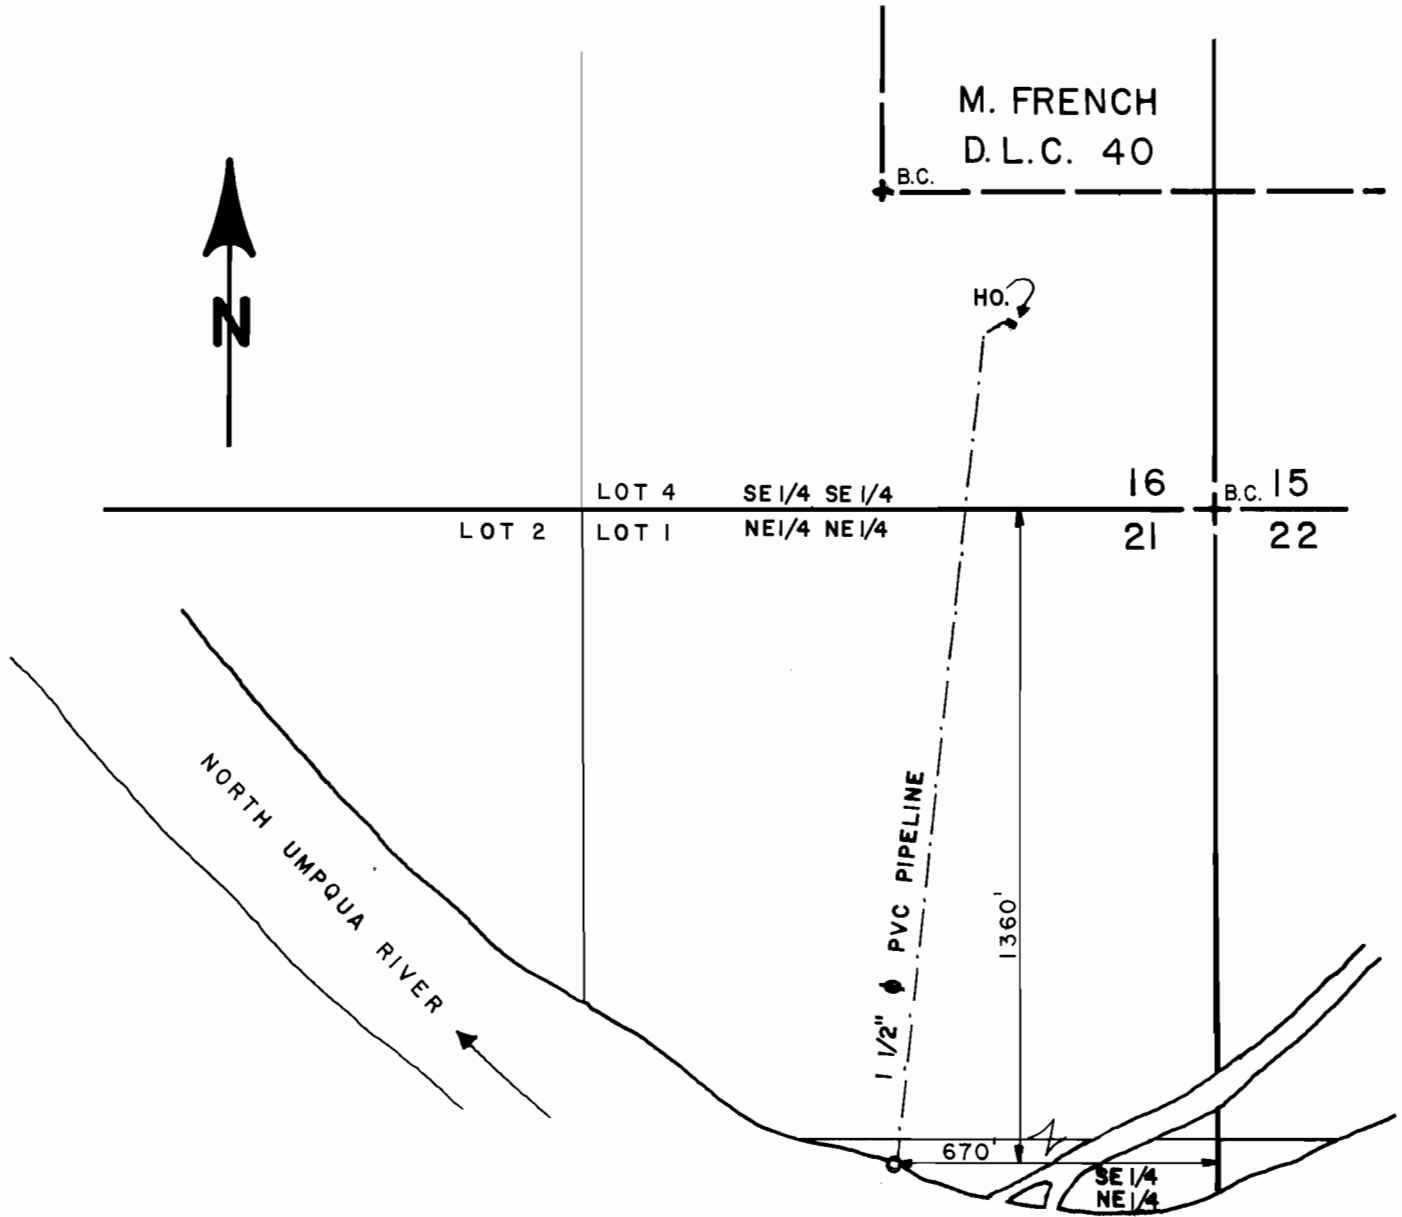

SCALE: 1" = 400'

## FINAL PROOF SURVEY UNDER

Application No. 68119..... Permit No. 49183.....

IN NAME OF

**GEORGE M. & JO CAROL KOBYLECKY**

Surveyed JULY 8 1985, by J.M.SCHMORDE.....