


T. 11 S., R. 7 W., W.M.

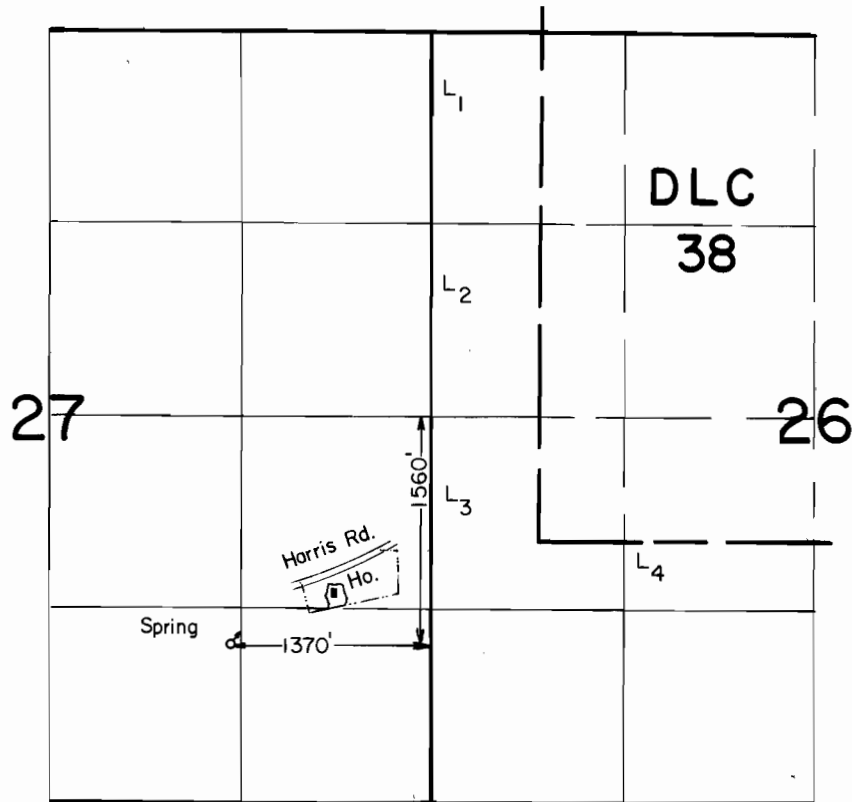

Scale: 1" = 1320'

FINAL PROOF SURVEY UNDER

Application No. 68338 Permit No. 49359

IN NAME OF

WILMA E. WISCHNOFSKE

Surveyed NOV. 17, 1987, by T. WARREN

*PTS w/FF
10/26/88 T.M.W.*