


RECEIVED
OCT 28 1985
WATER RESOURCES DEPT
SALEM, OREGON

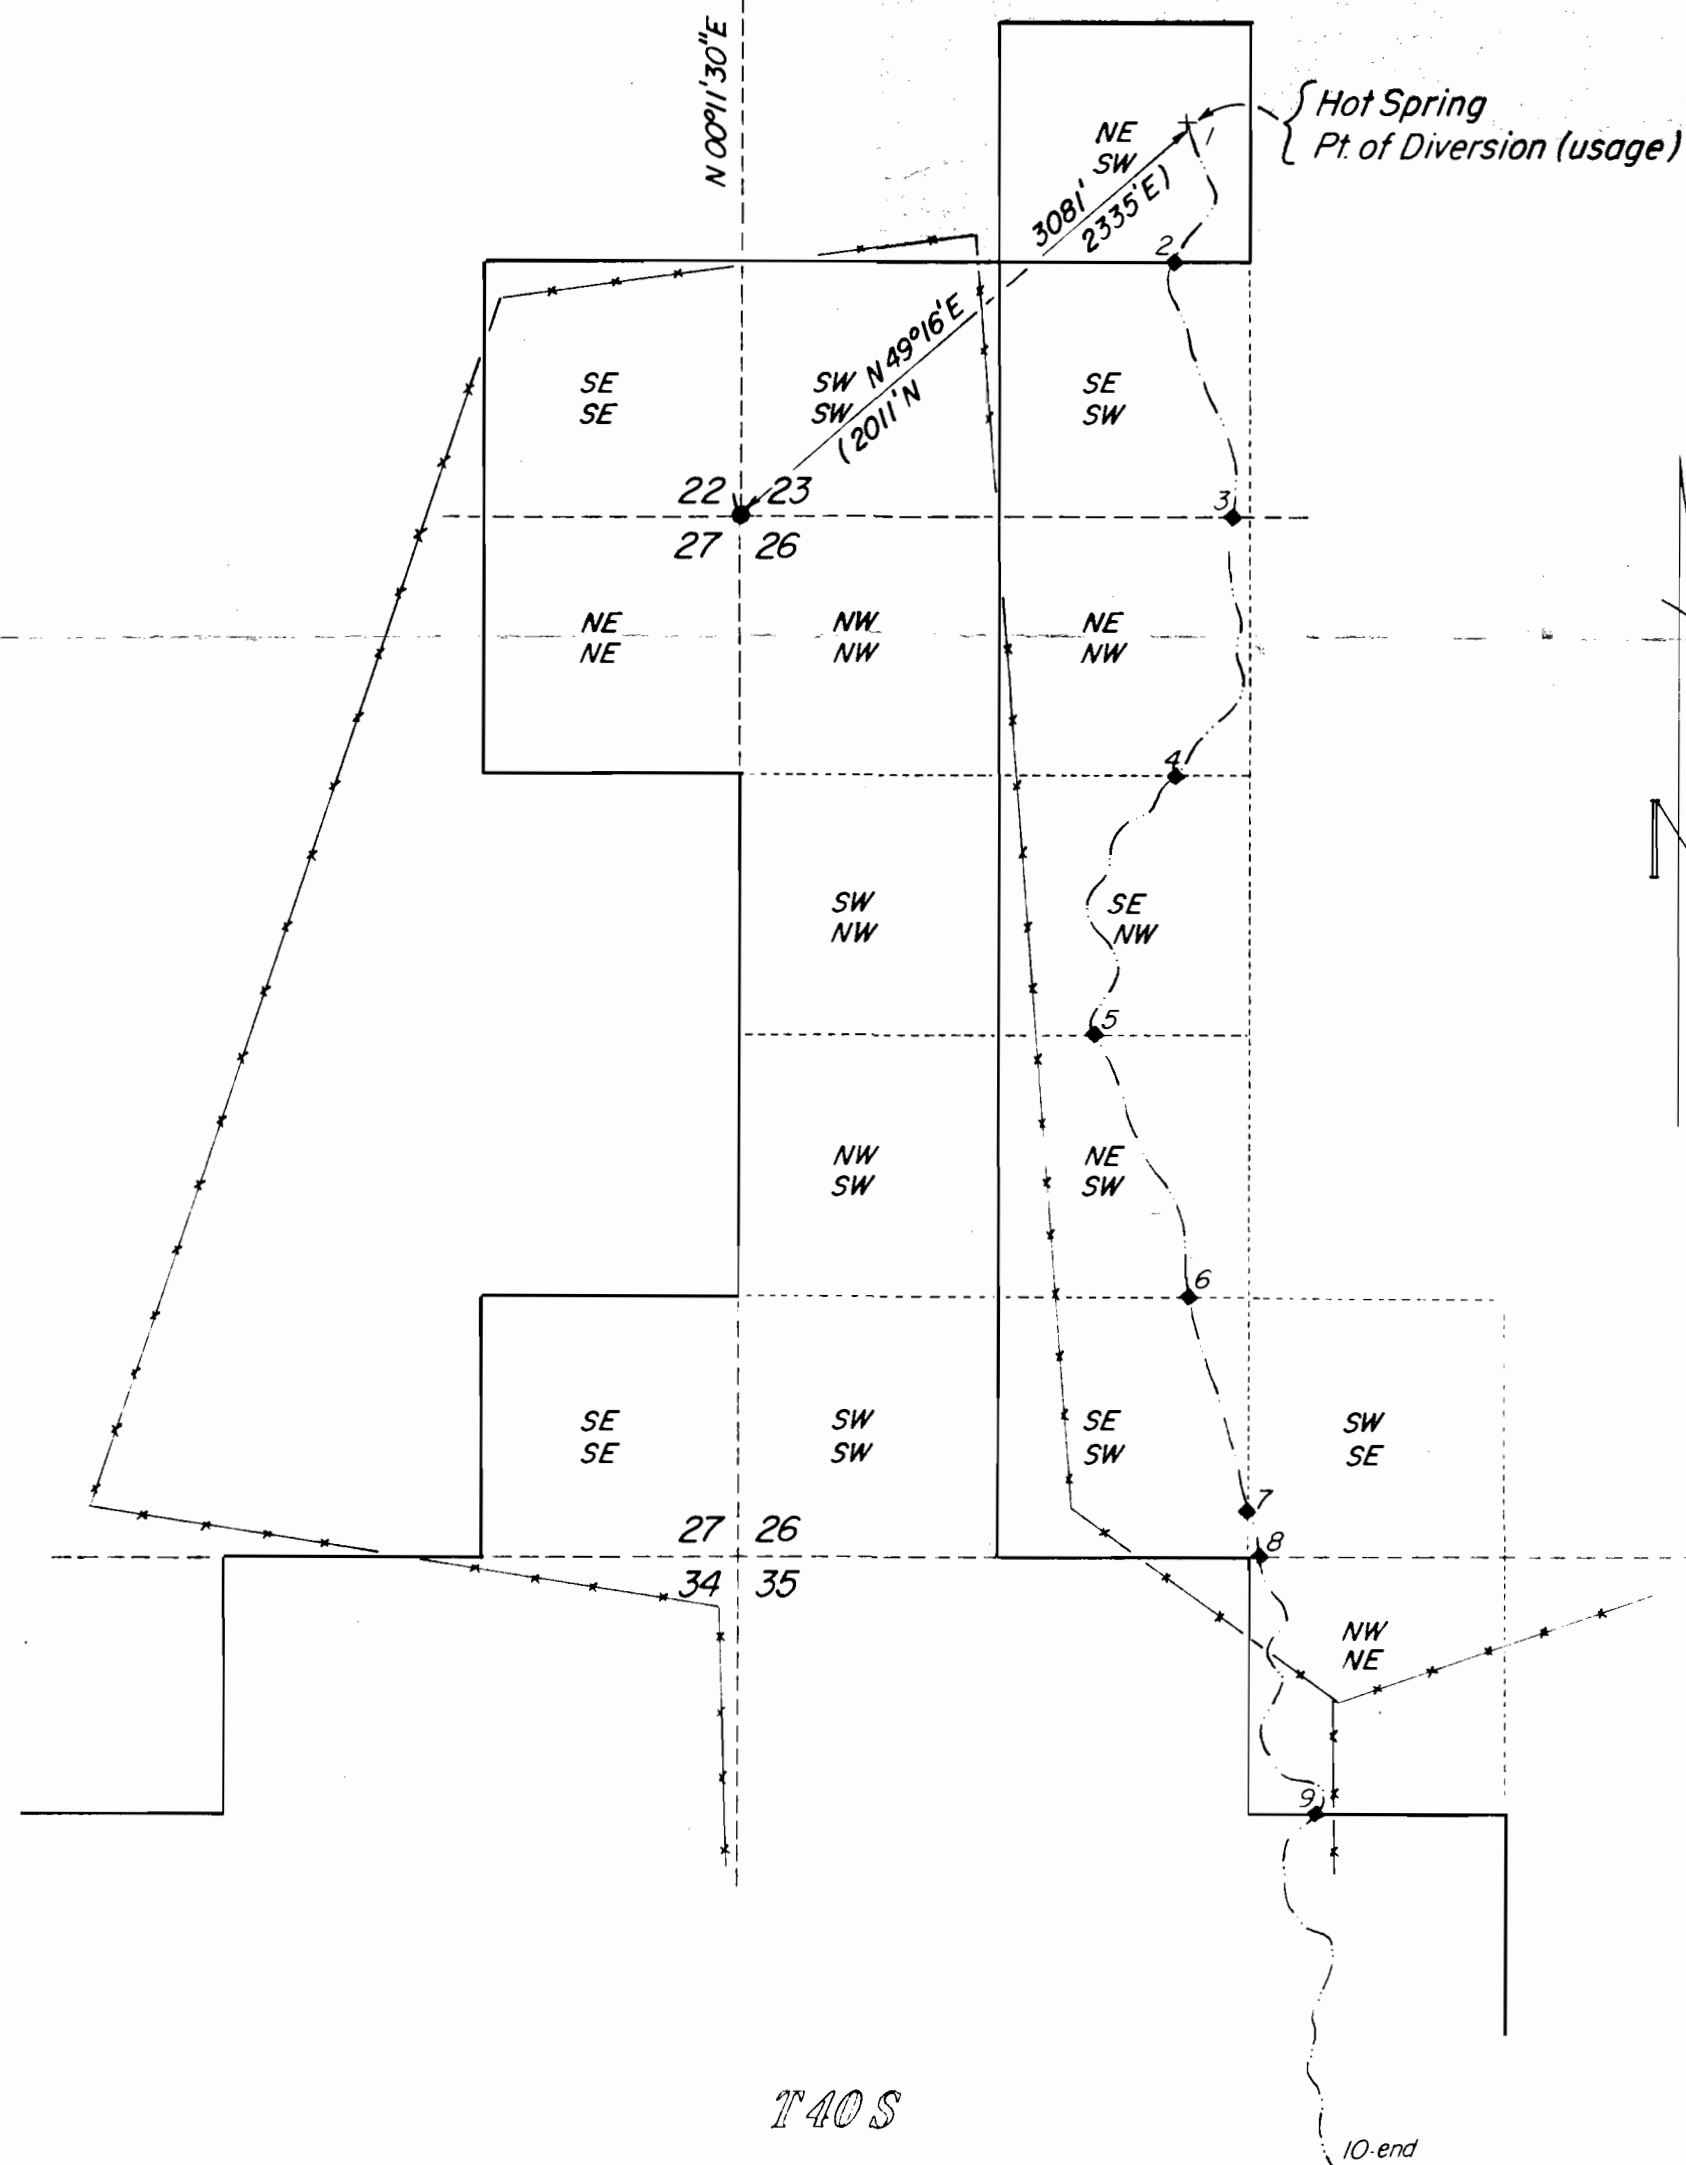

NOTES

1. Bearings are based on solar observations.
2. The GLO survey was done by James P. Currin, under contract no. 386, dated April 30, 1881.

LEGEND

- GLO corners found.
- Ditch line from the point of diversion.
- Ownership lines.
- Section lines.
- 1/4 and 1/16 Section lines.
- Fence lines.
- Points on the ditch line located at the approximate 40 acre boundary lines.

LOCATION OF THE DITCH FROM THE SECTION CORNER
COMMON TO SECTIONS 22, 23, 26 AND 27

POINT NO.	LOCATION
1 - start	2011 N, 2335 E
2	1320 N, 2224 E
3	000 N, 2557 E
4	1320 S, 2299 E
5	2640 S, 1868 E
6	3960 S, 2336 E
7	5132 S, 2640 E
8	5280 S, 2676 E
9	6600 S, 3056 E
10 - end	8460 S, 3140 E

RECEIVED
MAR 17 1986
WATER RESOURCES DEPT
SALEM, OREGON

Application No. 68471
Permit No. 49681

Revised-Oct. 22, 1985-CTP

	WHITEHORSE RANCH		FIELDS, OR.	
	SURVEY PLAT			
	POINT OF DIV. and DITCH LINE			
	Located in Sections 23, 26, 35, T 40 S, R 42 E, W 1; Malheur Co., Or.			
	Scale: 1"=1000'	Date: OCT. 18, 1985	Job: 952	
Dsn:	M. A. Palmer & Sons		Sht. No. 1	
Drn: CTP	ENGINEERING & SURVEYING			
Okd: CTP	254 N. Alder - Box 61			
	Burns, Oregon 97720			