90684

T.8S., R.5&6W., W.M.

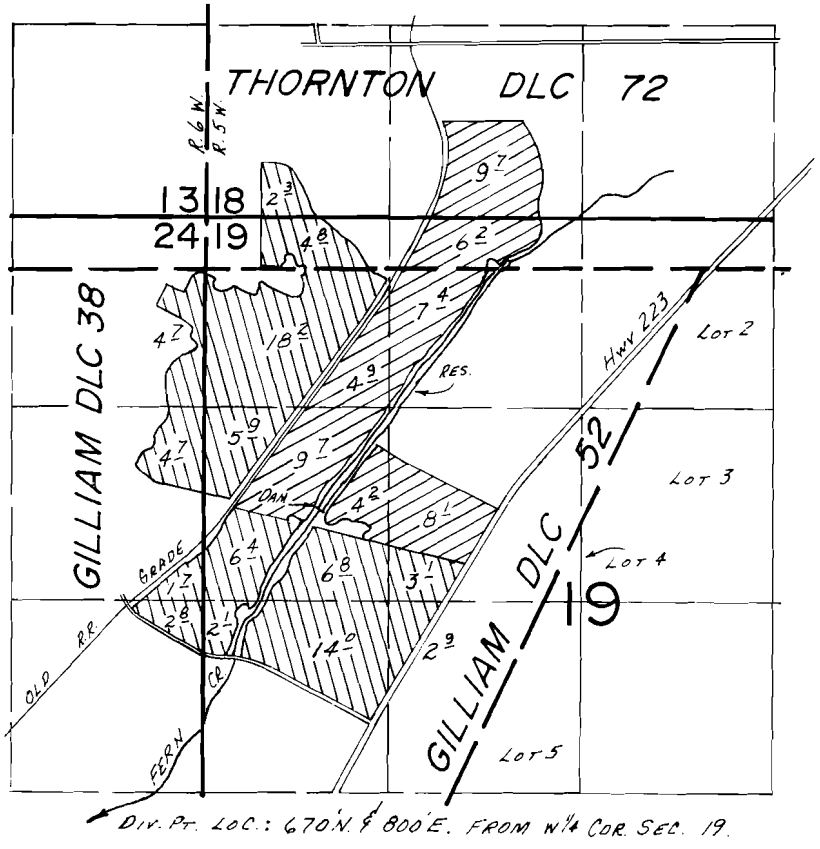

SCALE: 1" = 1320'

FINAL PROOF SURVEY

UNDER

54419 — 40807
R-49036 — R-5787
Application No. 49037 **Permit No.** 35828

IN NAME OF

MR. & MRS. SAM OBERG

Surveyed June 10 **19**76, **by** R.G. MUCKEN
Sept. 10 1981 L.M. TOLL

DFP-2P-131