


NOTE:

This drawing is intended to correct the proof survey for Certificate number 9752. The original proof survey for this certificate completed in 1932 incorrectly shows the house located on the NE 1/4 of the SW 1/4 of Section 10. The house in fact sets on the NW 1/4 of the SW 1/4 of Section 10. I am absolutely certain that this is the original house referred to in the original certificate.

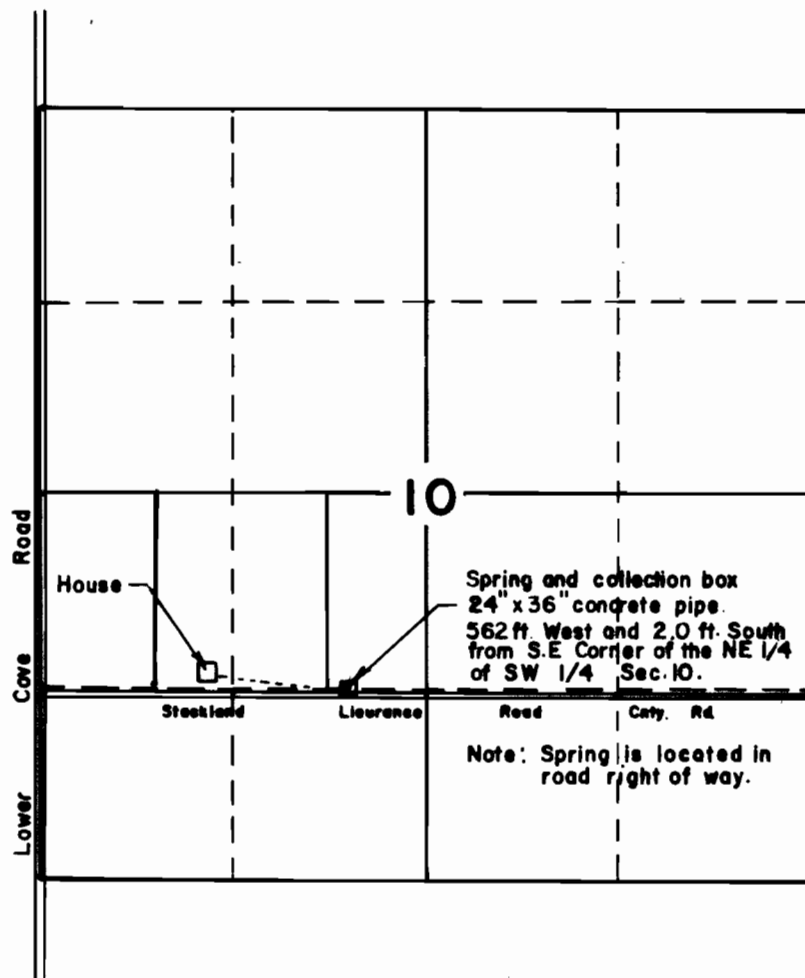

APPLICATION NO. 14531

PERMIT NO. 10530

NOTE:

The preparation of this map is for the purpose of identifying the location of the water right only and has no intent to provide dimensions or location of property ownership lines.



BAGETT - GRIFFITH & ASSOCIATES

LeGrande Oregon

Located in the Northwest 1/4 of the Southwest 1/4 of Section 10, Township 3 South Range 40, East of the Willamette Meridian

UNION COUNTY, OREGON

SURVEYED FOR	Nellie Denton	
SURVEYED BY	GTB	12-88
Scale: 4" = 1 Mile	Drawn by: GTB	12-88