


T.19S.,R.5W.,W.M.

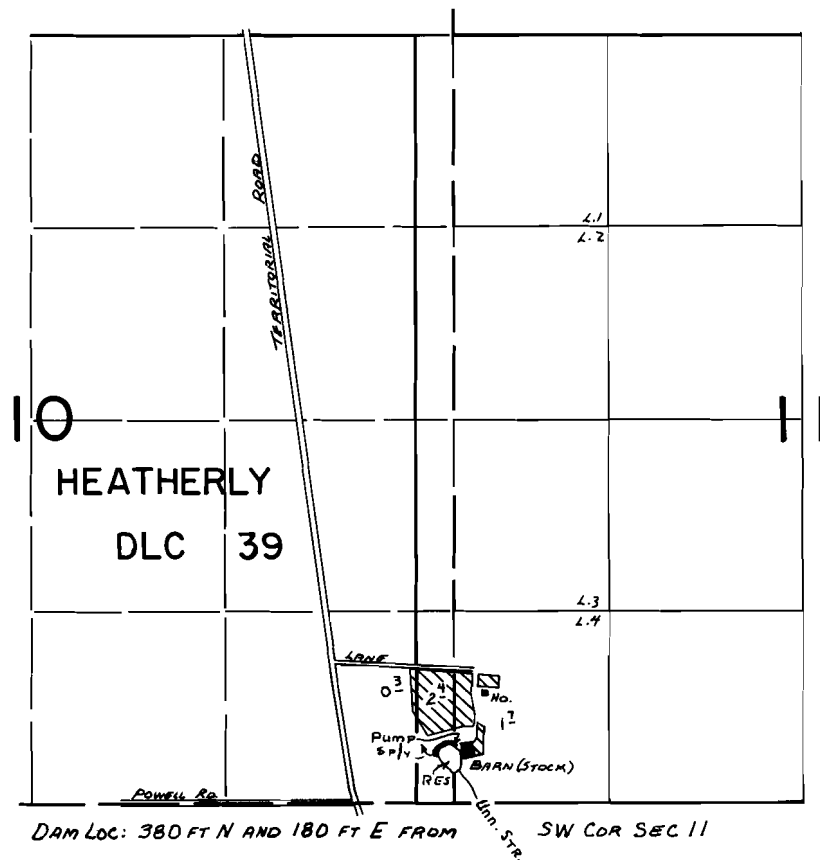

FINAL PROOF SURVEY
UNDER

Application No. R-56042 56043 Permit No. R-6742 42522
IN NAME OF

.....THERON C. ATKINSON.....

Surveyed May...3... 1982., by L.M. TOLL.....