


# T.4 N.R.27 E.W.M.

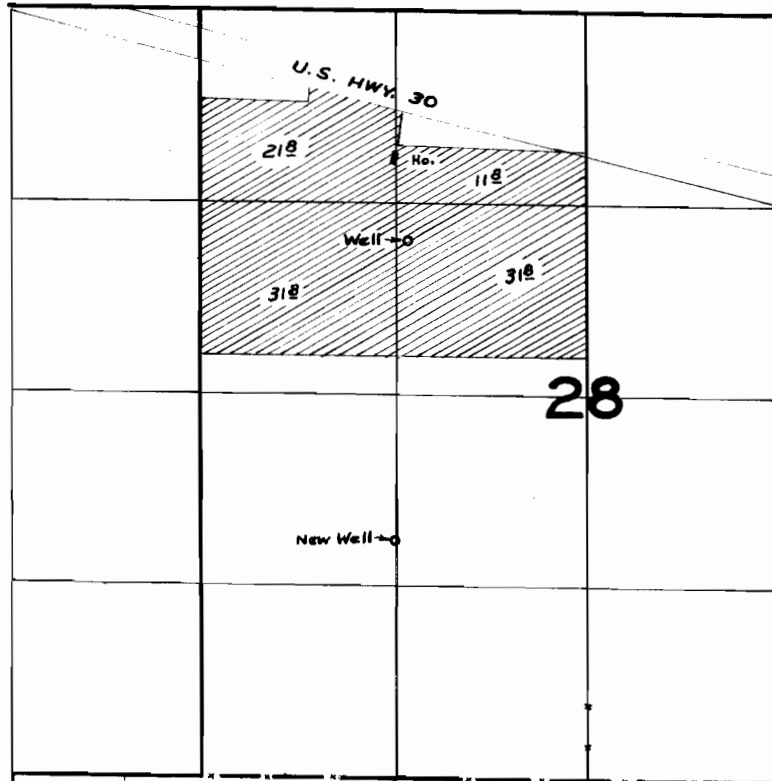

## FINAL PROOF SURVEY UNDER

Application No. U-544 Permit No. U-497  
IN NAME OF

SCOTT CHAPMAN

Surveyed 15 Oct. 1958, by T. Bish