


T.36S., R.1W., W.M.

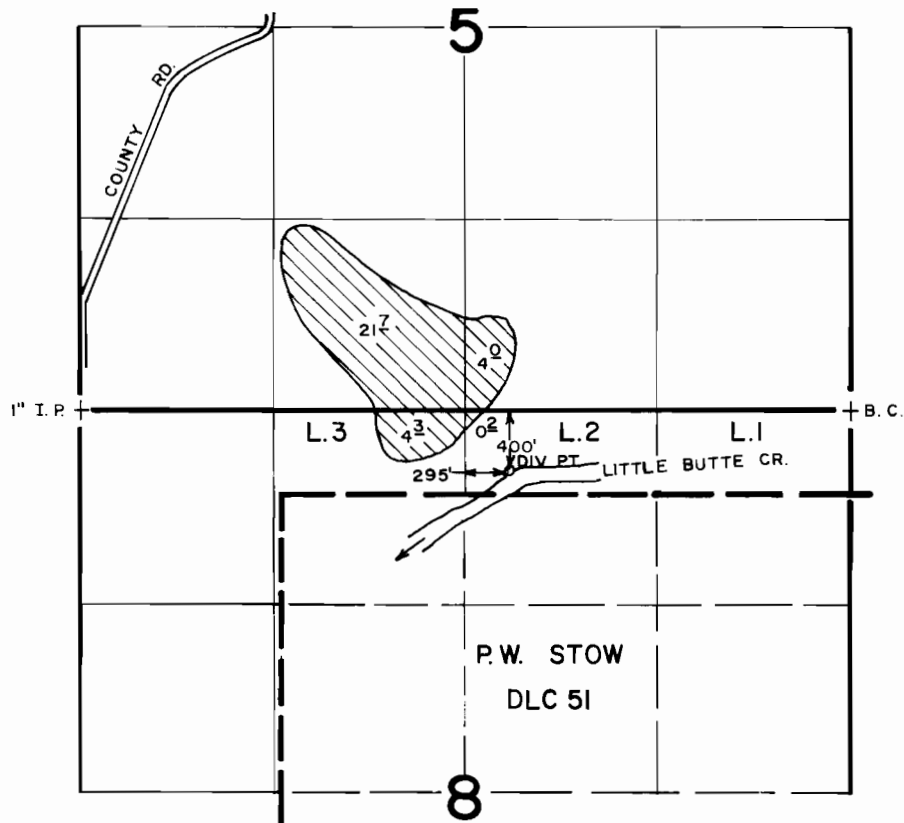

**FINAL PROOF SURVEY**  
UNDER

TRANSFER NO. 3603


Application No. .... Permit No. ....  
IN NAME OF

**JOHN N. & HARRIET M. WINTON**

Surveyed MAY 4, 1983, by B. S. JAMES

SCALE: 4" = 1 MILE

# T.36S. R.1 W.W.M.

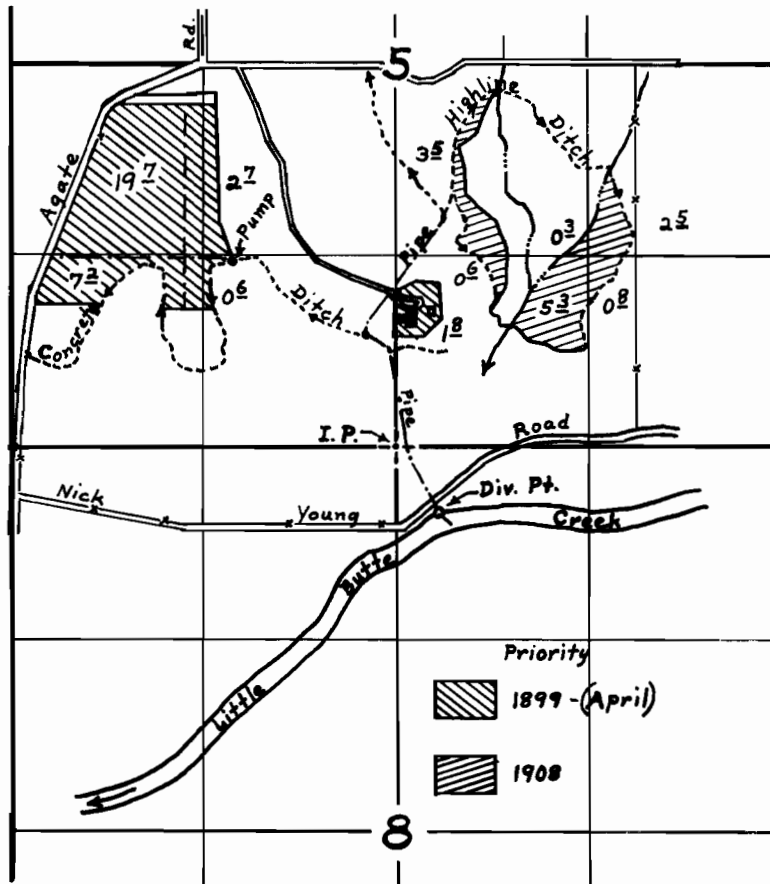

## FINAL PROOF SURVEY UNDER

Transfer No. W-82  
Application No. \_\_\_\_\_ Permit No. \_\_\_\_\_  
IN NAME OF

John N. Winton

Surveyed April 30, 1963, by D.C. Hendrix