


T. 5 S., R. 1 W., W.M.

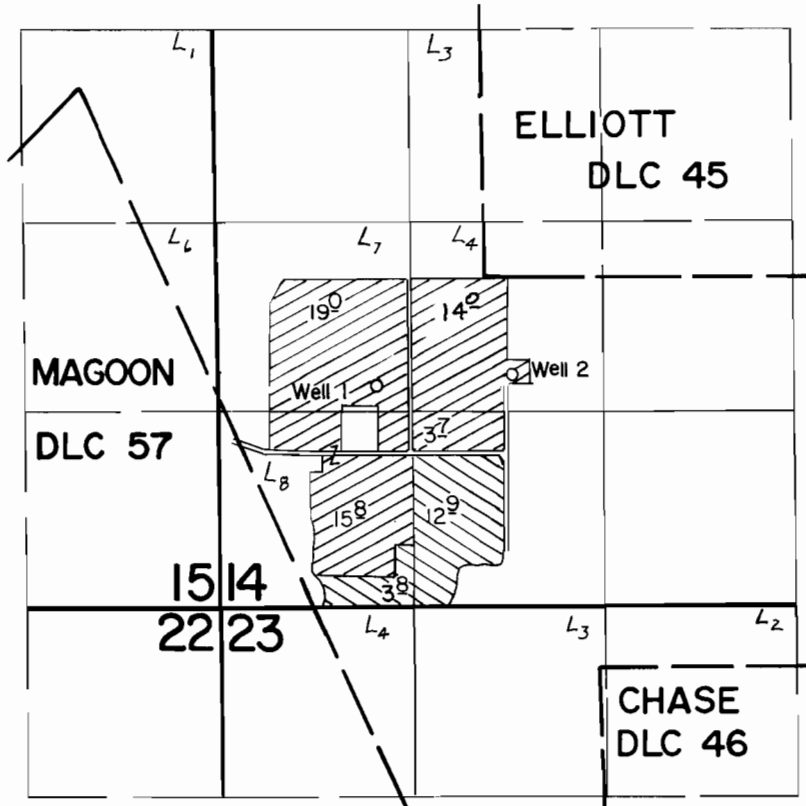

Well 1 Loc. : 720' S. & 740' W.

Well 2 Loc. : 660' S. & 180' E. ; both from SW Cor.

Elliott DLC 45.

Scale: 1" = 1320'

 Primary
 Supplemental

FINAL PROOF SURVEY UNDER

Application No. ~~G-7269~~ Permit No. ~~G-6708~~.....

IN NAME OF

VERN CLAYTON JOHNSON

Surveyed ~~JUNE 26 1985~~, by ~~J. WARREN~~.....