


T 1N., R. 39E., W. M.

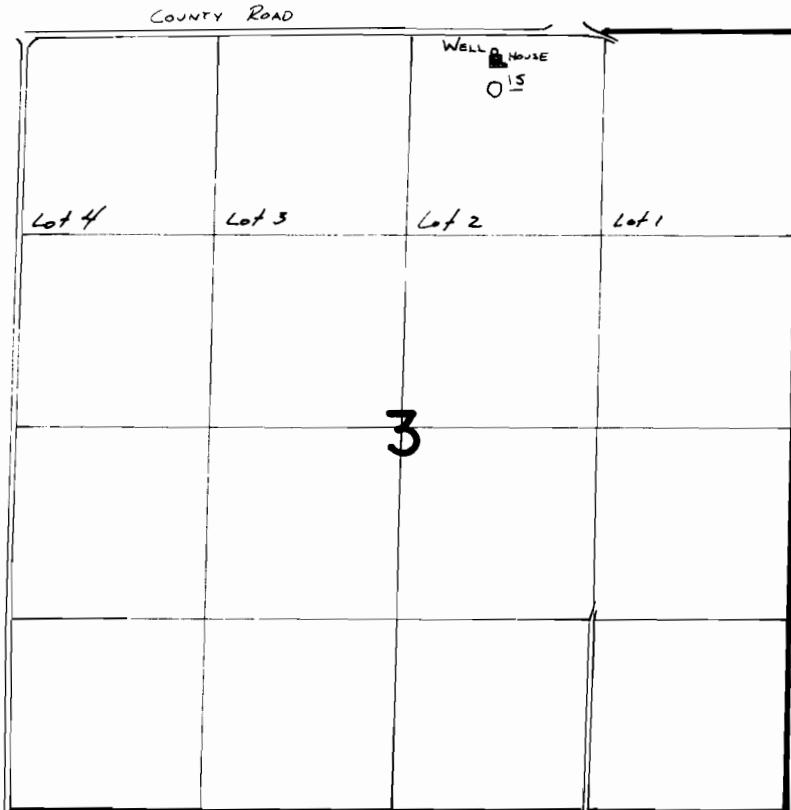

Scale: 1" = 1320'

WELL Loc: 2590' N. & 560' E. FROM CENTER COR. SEC 3

FINAL PROOF SURVEY
UNDER

Application No. **G-8315** Permit No. **G-7688**
IN NAME OF

ARTHUR WESLEY BOSS

Surveyed **7-11** 19**88**, by **V.L. Church**