


T. 4S., R. 39 & 40E., W. M.

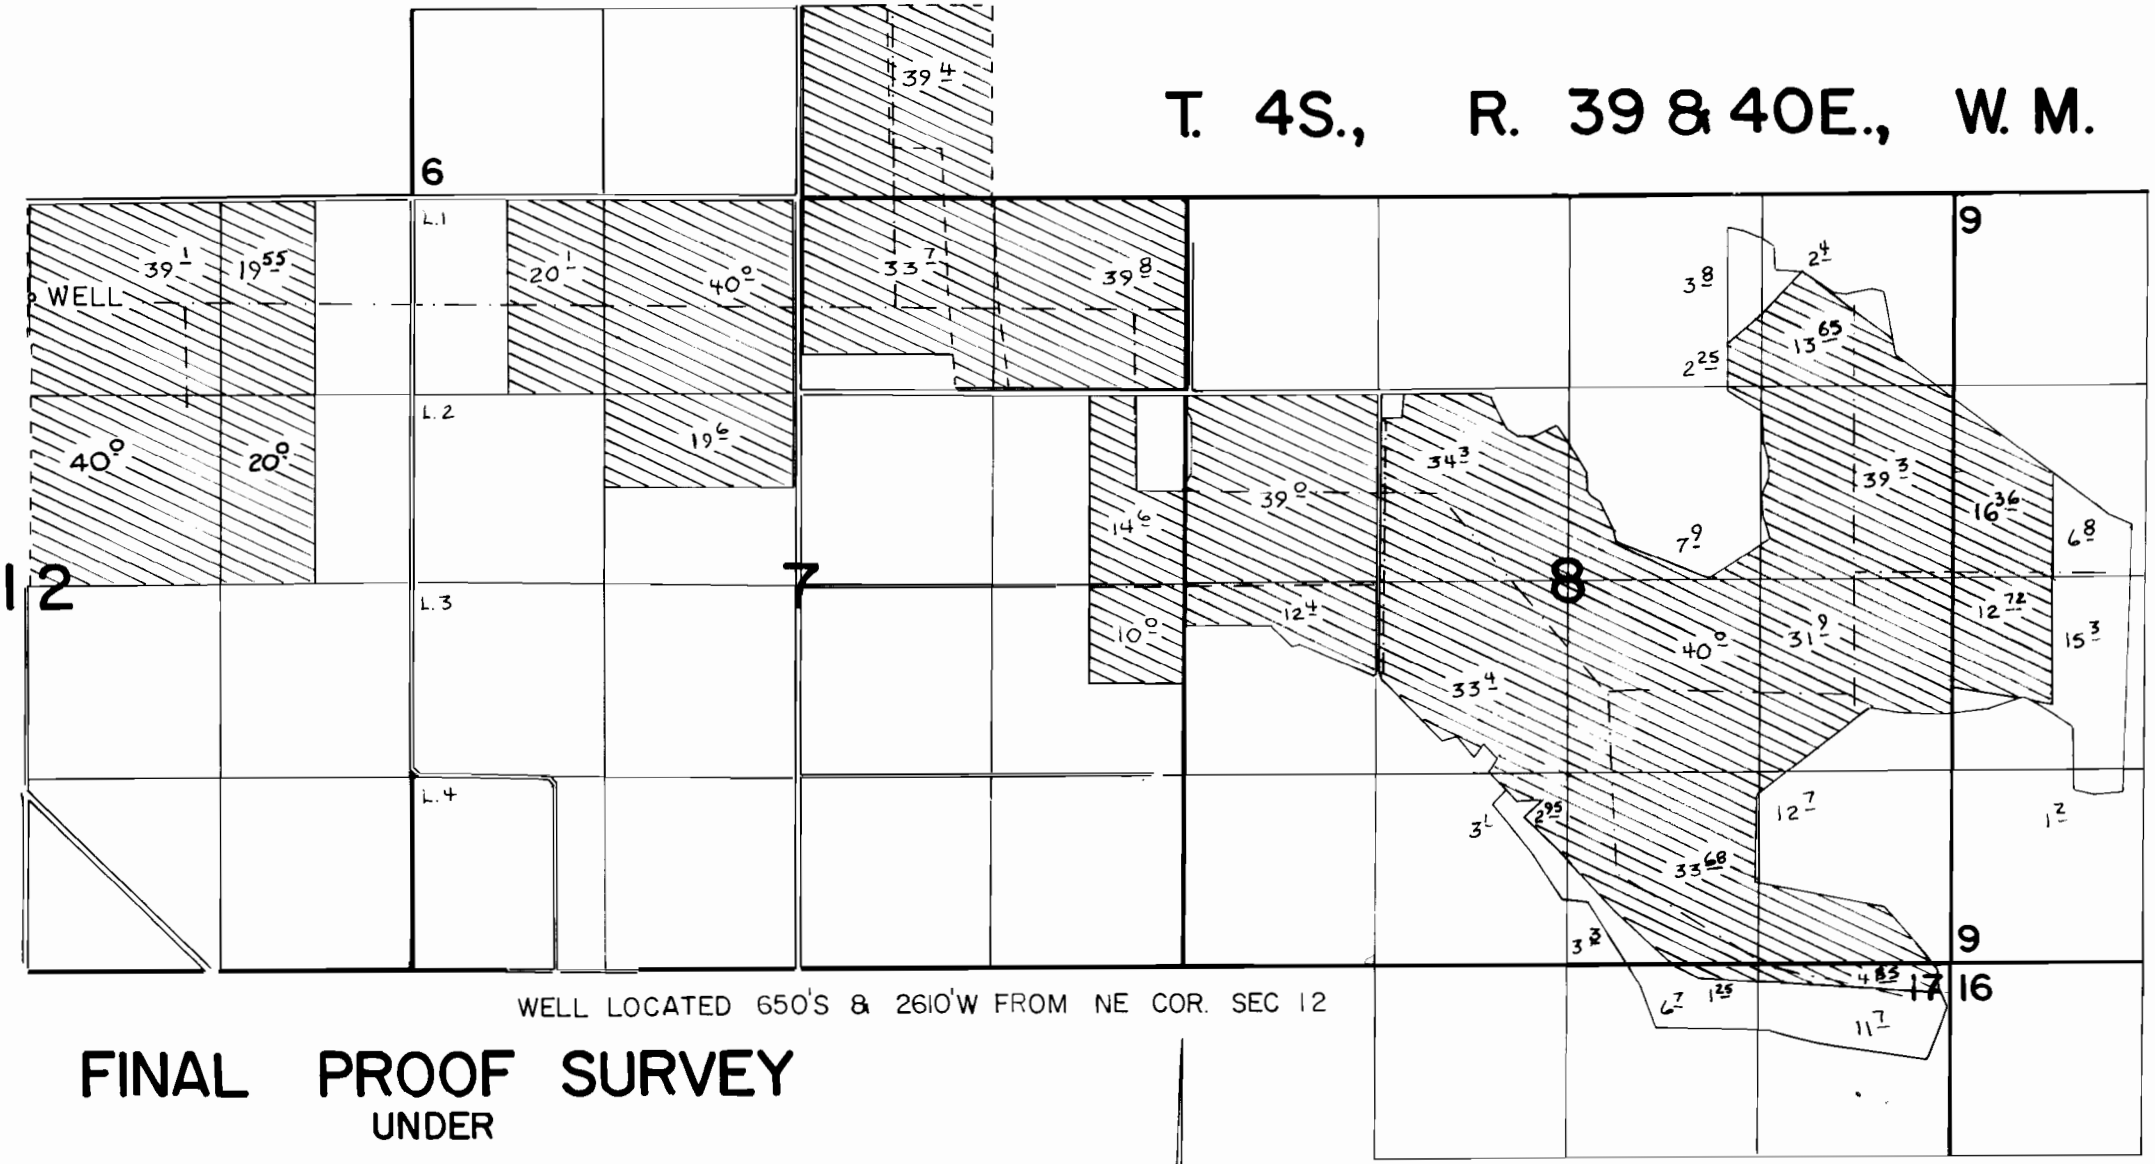

WELL LOCATED 650'S & 2610'W FROM NE COR. SEC 12

FINAL PROOF SURVEY

UNDER

APPLICATION G-8580 PERMIT G-7976
IN NAME OF

CARL G. & GIL HELM

Surveyed 7-9-1984, by V.L. Church

SCALE: 1" = 1320'