


T. 28S., R. 14W., W.M.

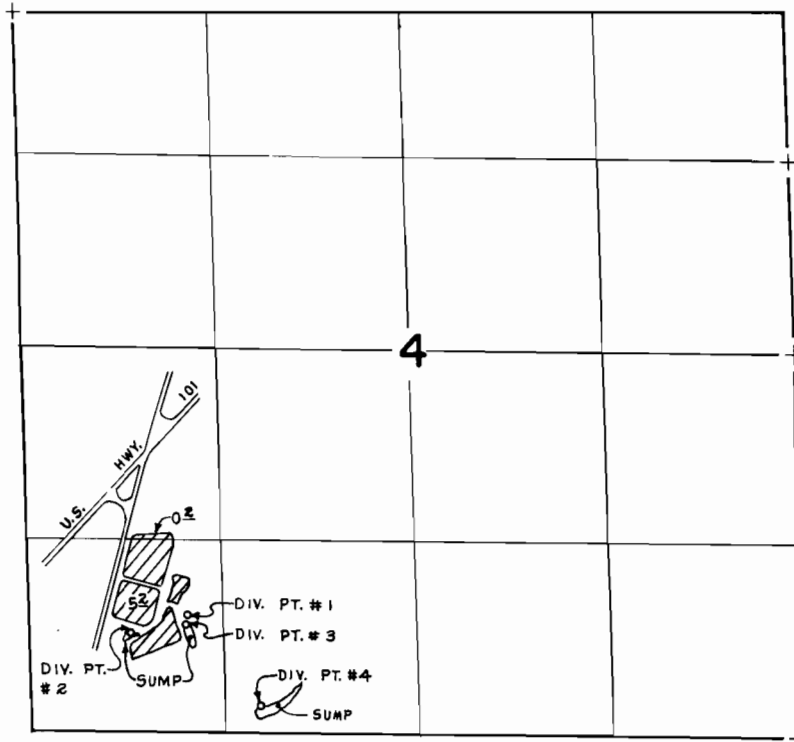

DIV. PT. #1 WELL LOCATED 4,150' S. & 1,185' E. FROM N.W. CORNER SECTION 4
 DIV. PT. #2 LOCATED 4,270' S. & 790' E. FROM N.W. CORNER SECTION 4
 DIV. PT. #3 LOCATED 4,215' S' & 1,170' E. FROM N.W. CORNER SECTION 4
 DIV. PT. #4 LOCATED 4,780' S. & 1,680' E. FROM N.W. CORNER SECTION 4

SCALE: 4"=1mile
FINAL PROOF SURVEY
 UNDER

Application No. G-8611. Permit No. G-8007.
 IN NAME OF

.....RONALD F. KASPER.....

Surveyed SEPT. 11, 1984, by L. CASHION.