


T. 36 S., R. 2 W., W.M.

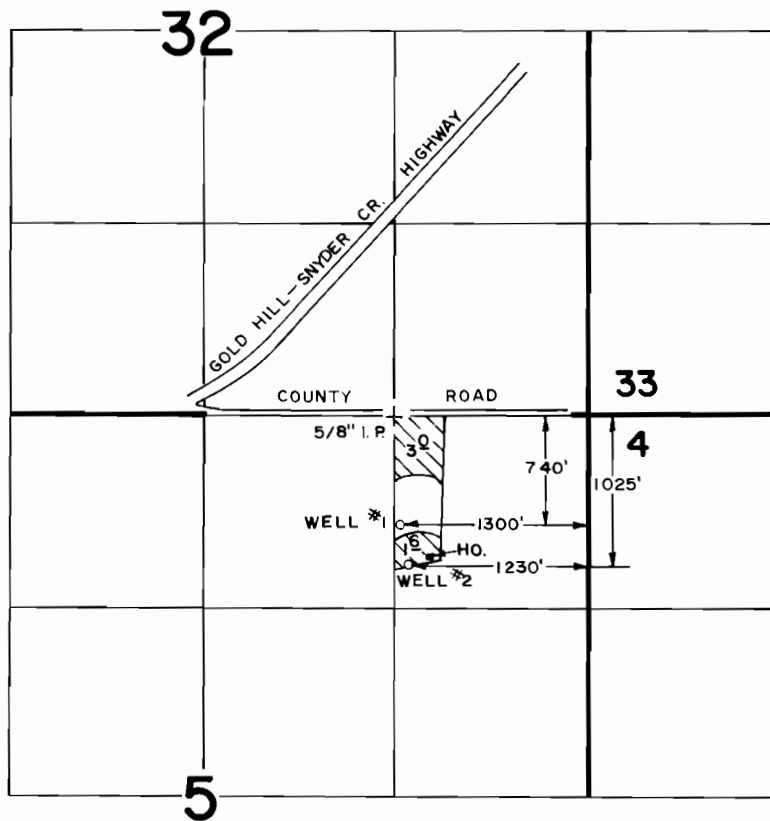

FINAL PROOF SURVEY
UNDER

Application No. G-8617 Permit No. G-8065
IN NAME OF

WILFORD & ELIZABETH SIGHTS

Surveyed FEB. 4 1983, by B. SUZIE JAMES

SCALE: 4" = 1 MILE