


T.2S. R.12E. W.M.

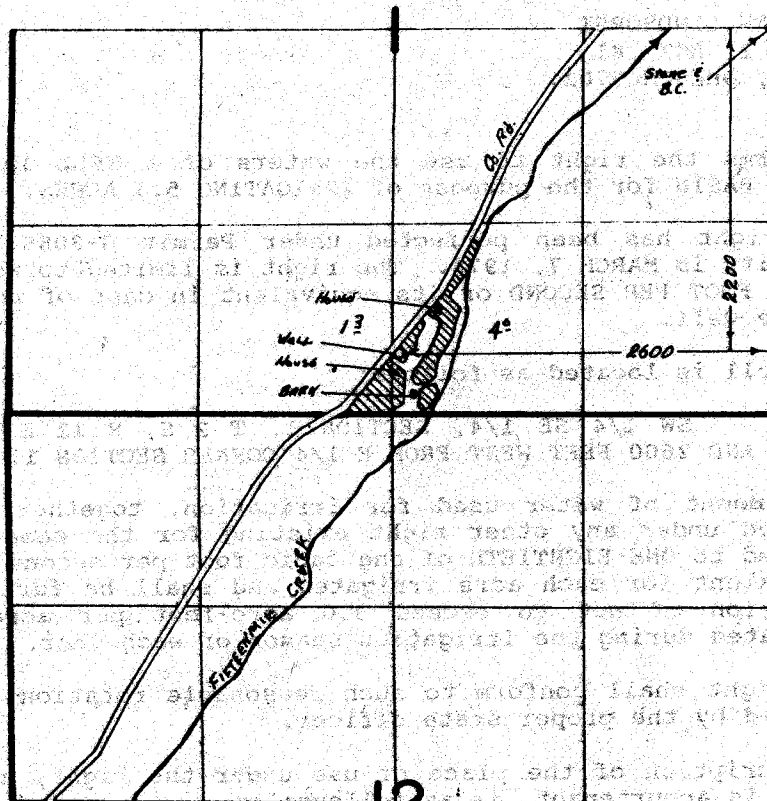

12

FINAL PROOF SURVEY
UNDER

Application No. **G-8678** Permit No. **G-8088**
IN NAME OF

LINDHORST

Surveyed May, 6 1983, by T. J. Paul