


T.4S., R.2W., W.M.

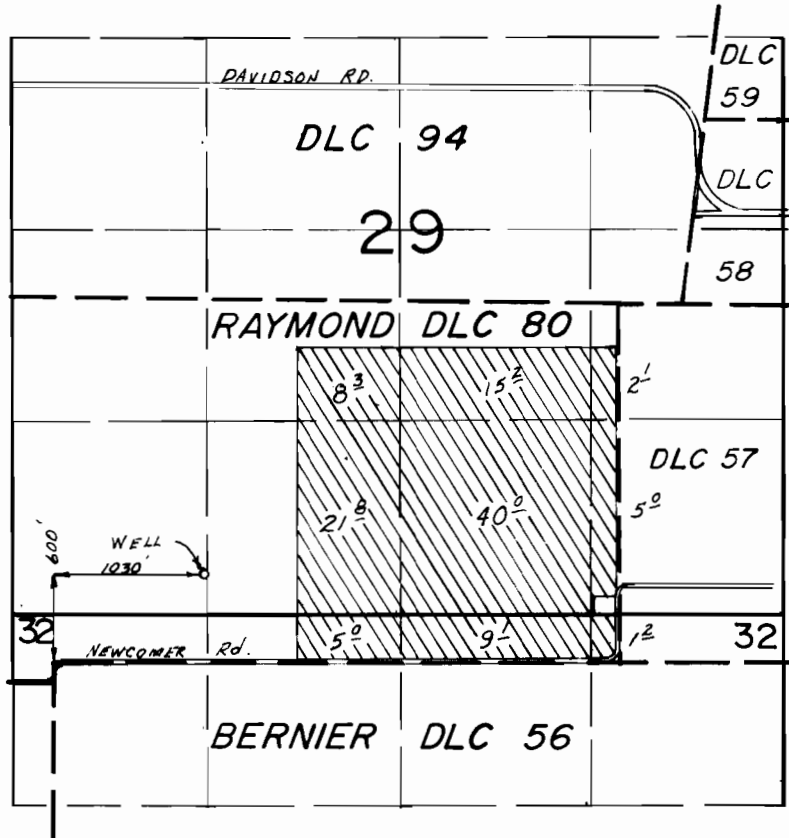

**FINAL PROOF SURVEY**  
UNDER

Application No. G-8692 Permit No. G-8021.....  
IN NAME OF

.....RAY DAVIDSON.....

Surveyed Sept. 27.. 19.83, by L.M.TOLL.....