


# T.13S.,R.1W.,W.M.

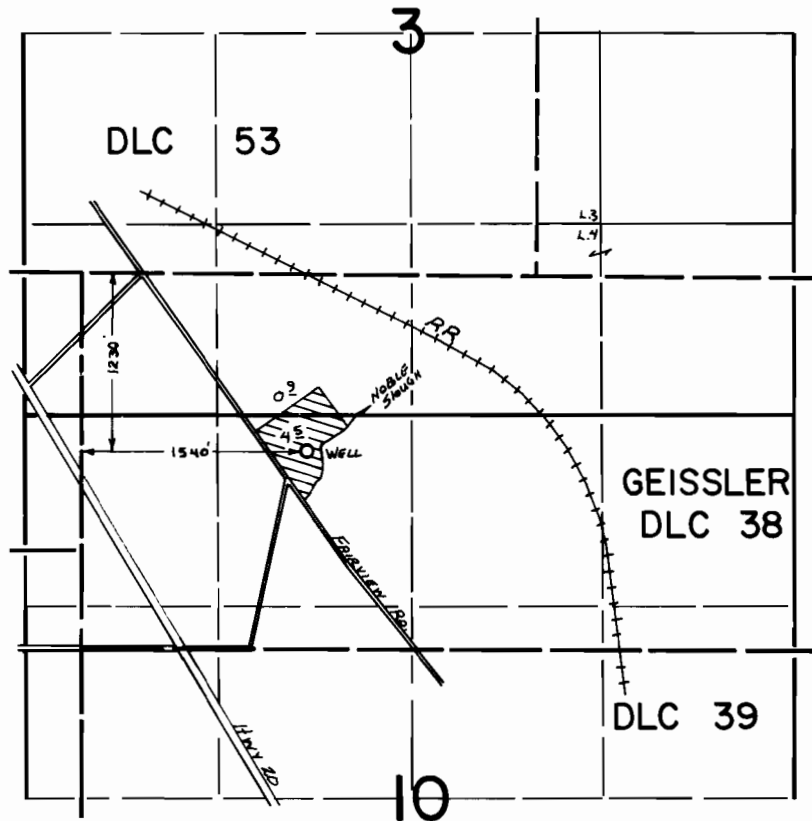

## FINAL PROOF SURVEY UNDER

Application No. ..G.:8737. Permit No. ..G:8083...  
IN NAME OF

RONALD...G... & GLORIA...F... NELSON

Surveyed .April..29.. 19.82., by ..L.M..TOLL.....