


T. 3S., R. 38E., W. M.

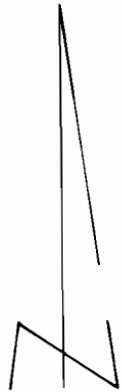

SCALE 1" = 1320'

12	COUNTY	ROAD	12
13			13

13
0'
WELL

WELL LOC: 1650' N. & 1380' W. FROM E 1/4 COR. SECTION 13

FINAL PROOF SURVEY
UNDER

Application No. ~~6-2604~~ Permit No. ~~6-8970~~
IN NAME OF

DAVID A. OSMICK & JOANNE E. COWLING

Surveyed 11-9-1987, by V.L. Church