


T. 3S., R. 38E., W. M.

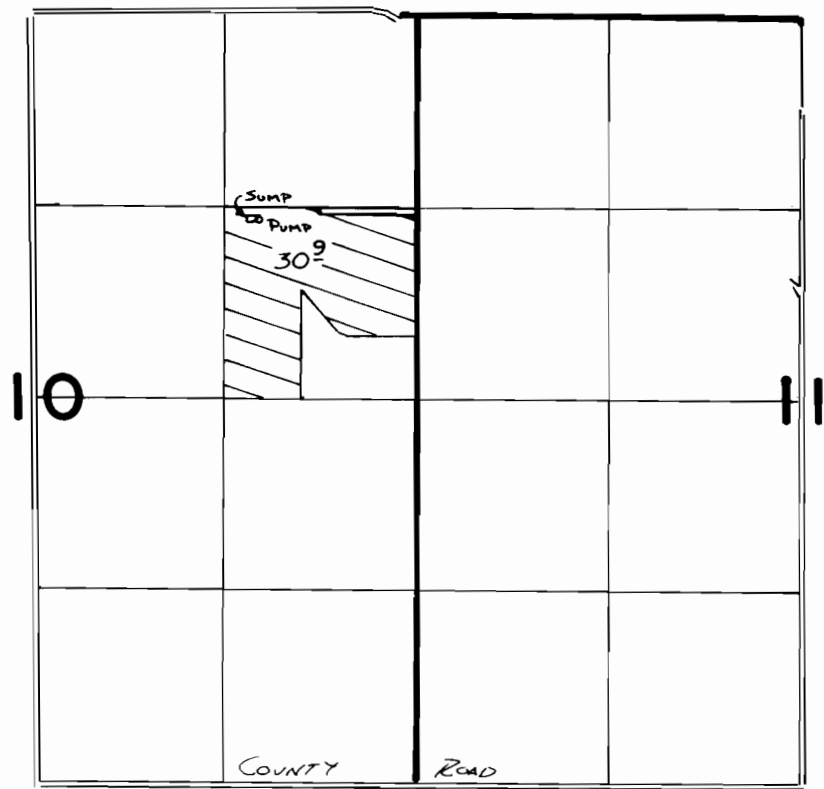

SCALE 1" = 1320'

Sump Loc.: 1240' N. & 1080' W. From E 1/4 Cor. Sec. 10

FINAL PROOF SURVEY
UNDER

Application No. **G-9628** Permit No. **G-9053**
IN NAME OF

ALLEN HASEL, JR.

Surveyed **11-9** 19**87**, by **V.L. Church**