


T2N, R9&10W, WM

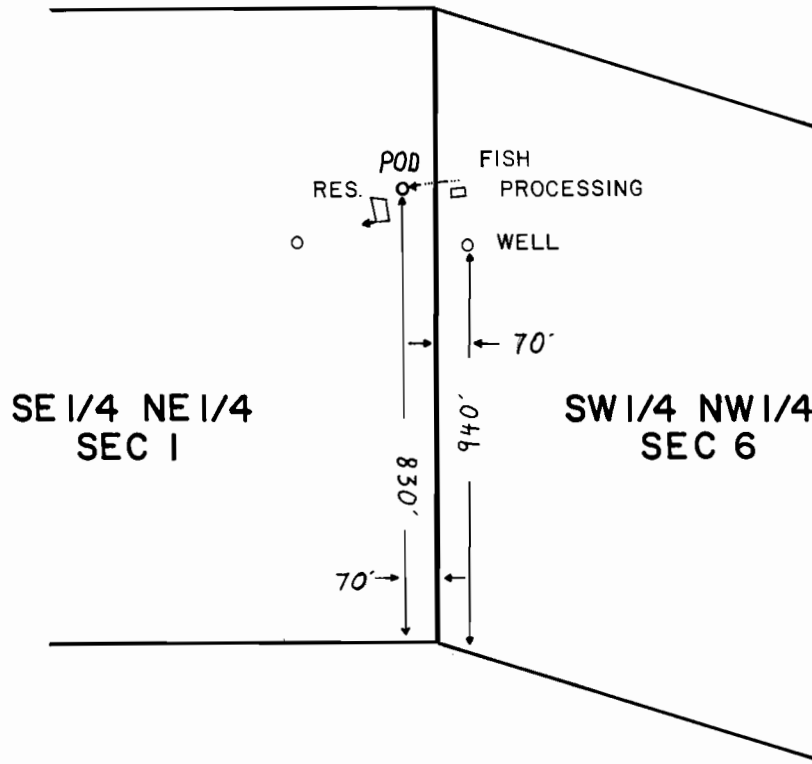

FINAL PROOF SURVEY UNDER

G-9846 G-9213
 R-61788 R-8299
 Application No. 61789... Permit No. 45978.....

IN NAME OF

ROBERT L. & SHIRLEY M. MAI.....

Surveyed OCT. 1..... 1987., by T.M. WARREN.....