


T.IOS., R.4E., W.M.

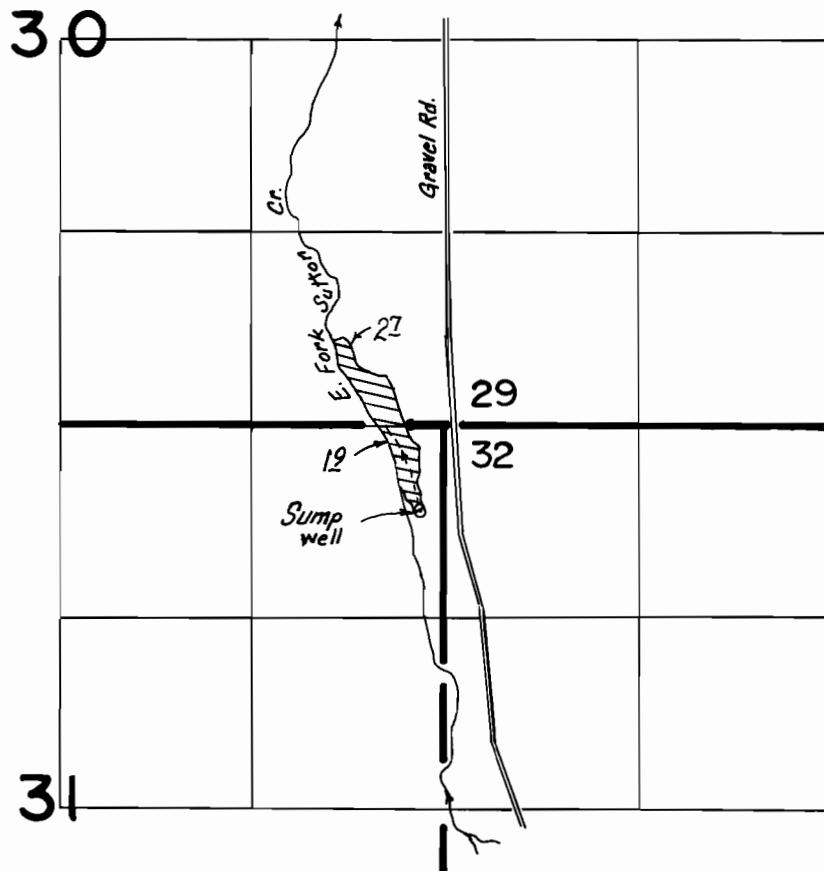

The location of the sump well is 550' S. & 150' W. from NE cor. sec. 31.



Scale: 1" = 1320'

FINAL PROOF SURVEY

UNDER

Application No. G10092 Permit No. G9196
IN NAME OF

ALAN V. & BONNIE R. BAHN

Surveyed 6-3-1988, by Vern Church