


T. 2 S., R 2 W., W.M.

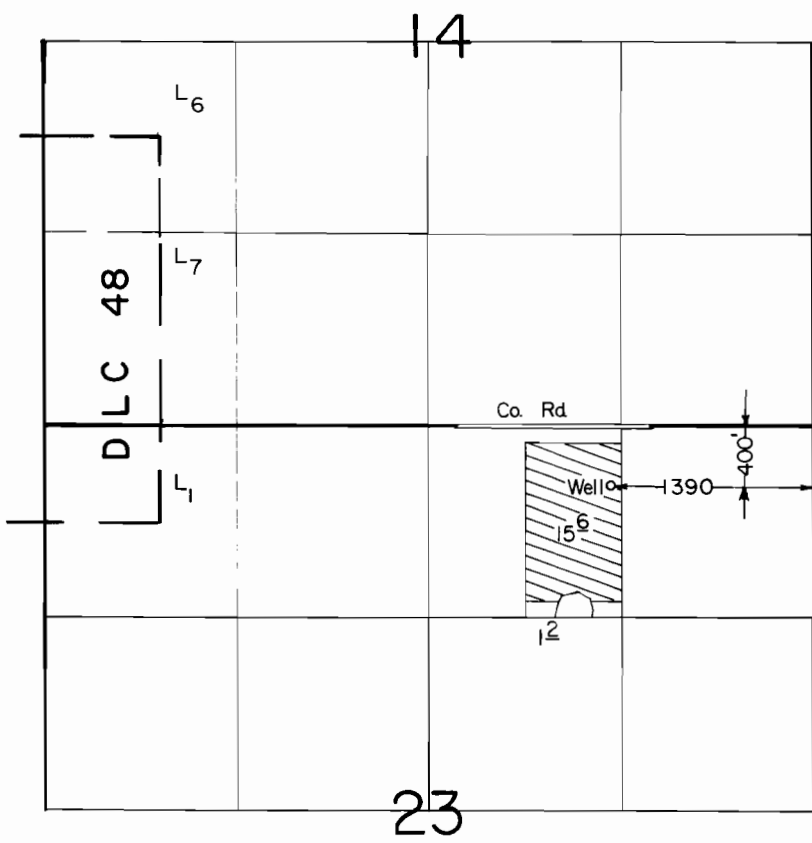

Scale : 1" = 1320'

FINAL PROOF SURVEY
UNDER

Application No. G-11212 Permit No. G-10322
IN NAME OF

CHARLES HUCKINS

Surveyed JUNE 3 1988, by T. Warren

41067-178-164A
11/7/88 TMW