


T. I. N., R. I. W., W. M.

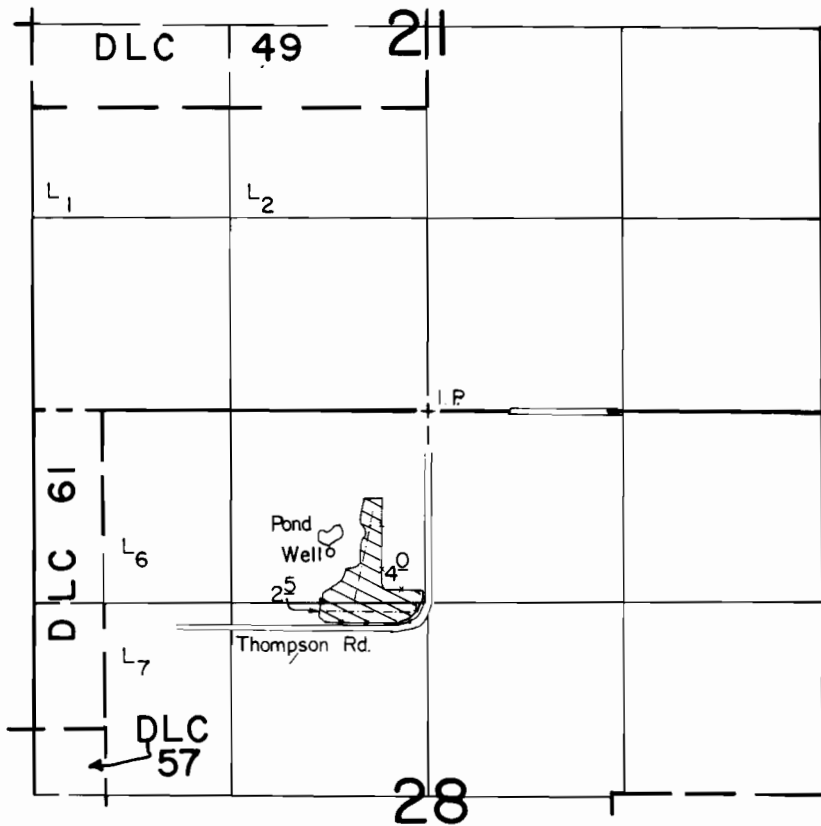

Well Loc. : 980' S. & 660' W. from N. 1/4 Cor. Sec. 28.

Scale: 1" = 1320'

FINAL PROOF SURVEY UNDER

R-68939

R-10815

Application No. G-11566 Permit No. G-10667

IN NAME OF

WALLACE L. PREBLE

Surveyed AUG. 31 1988, by T. Warren