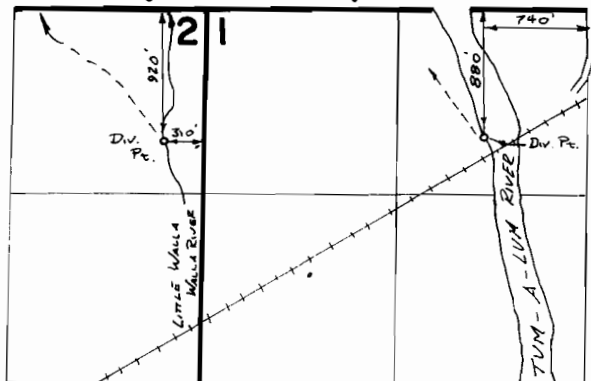


FINAL PROOF SURVEY

UNDER

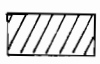
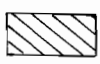
T. 5N., R. 35E., W.M.



APPL. 43280 PER. 32145
IN NAME OF

HUDSON BAY DIST. IMPROVEMENT CO.

SURVEYED MAY 5, 1978 BY R. BARWIN

 PRIMARY  SUPPLEMENTAL

STATE OF WASHINGTON

T. 6N., R. 34E., W.M.

