


T.10S.,R.46E.,W.M.

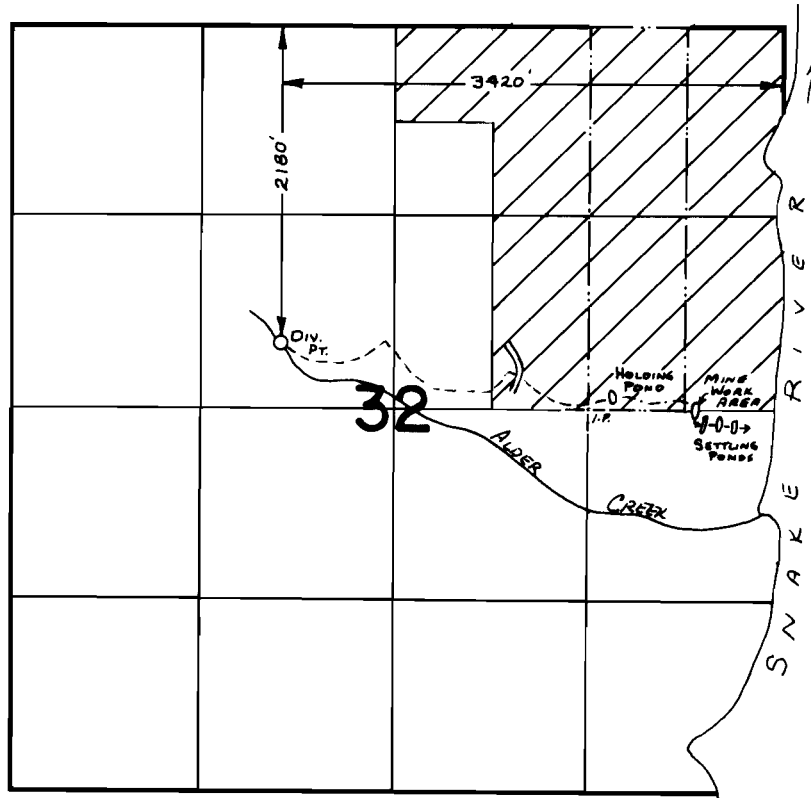

SCALE: 1" = 1320'

FINAL PROOF SURVEY
UNDER

Application No. 51043 42789
60626 Permit No. 45377.....
IN NAME OF
ELMER L. BROWN &
ELWIN E. BUTCHER.....

Surveyed Nov. 16, 1978, by R. F. BARWIN....
Sept. 25, 1985 L. M. TOLL

PTS 1978 P-E LMT
PTS 1985 Y-A