


T.2S. R.4E. W.M.

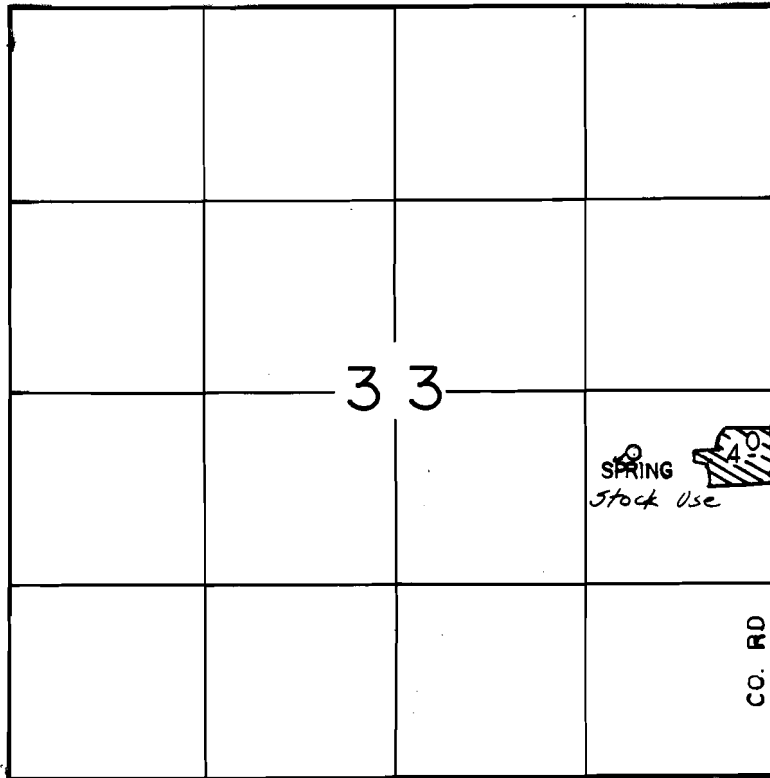

SPRING LOC. 2150' N. & 950' W. FROM THE S.E. COR. SEC. 33

SCALE: 1" = 1320'

FINAL PROOF SURVEY
UNDER

Application No. 56129 Permit No. 43758
IN NAME OF

CECIL MEISER

Surveyed JUNE 29, 1987, by T.M. WARREN