


# T8N, R7W, WM

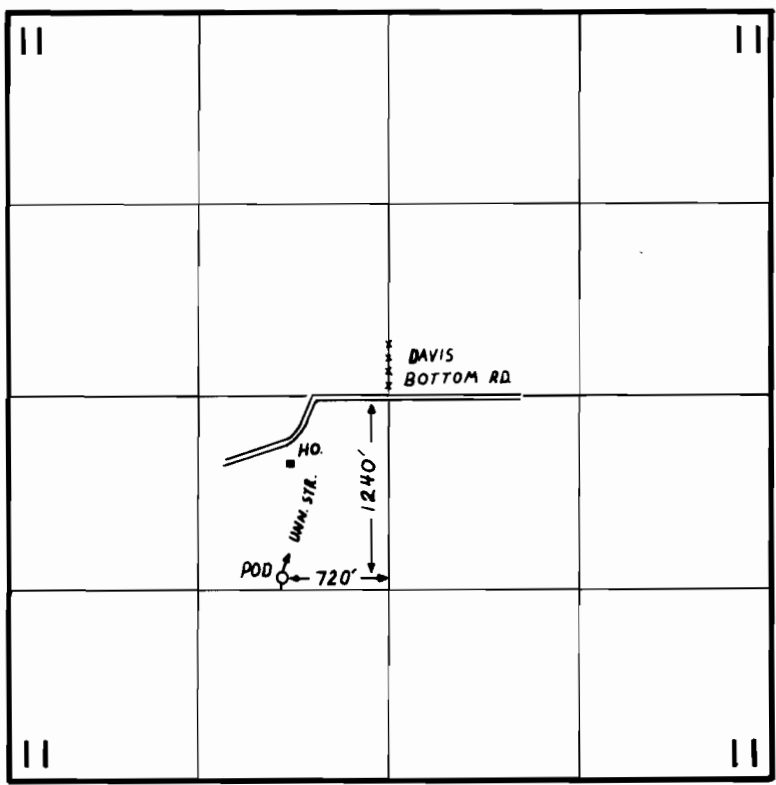

1" = 1320'

## FINAL PROOF SURVEY UNDER

Application No. 56175 Permit No. 42502  
IN NAME OF

CARL F. & WILMA AARNIO

Surveyed JULY 20 1988, by T.M. Warren