T.16S.,R.47E.,W.M.

PRELIMINARY
SUBJECT TO REVISION

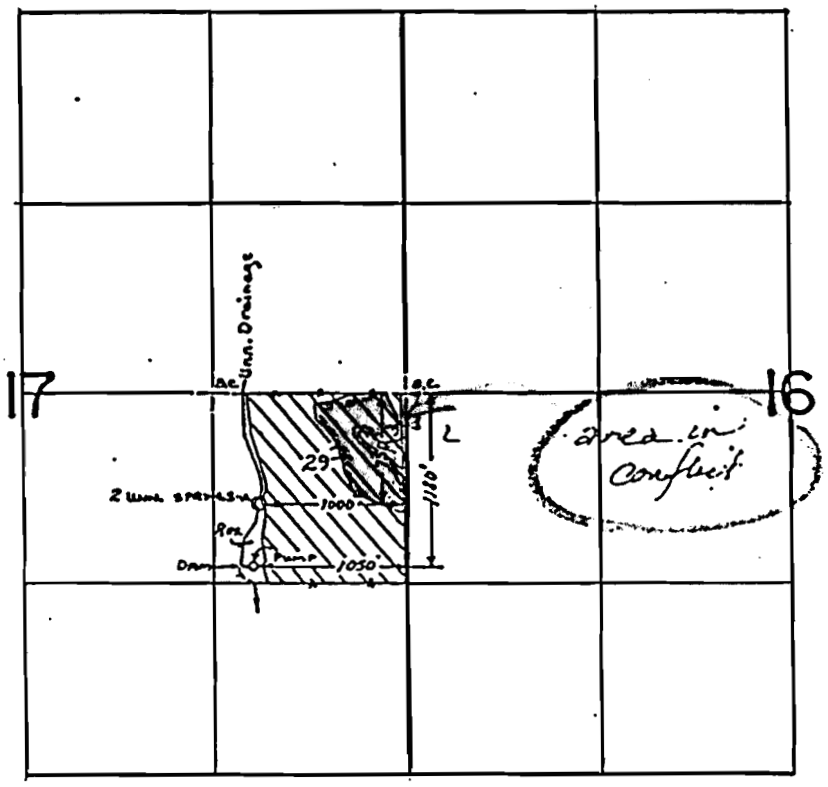

PRELIMINARY
SUBJECT TO REVISION

FINAL PROOF SURVEY
UNDER

Application No. R-56816 (56696) Permit No. R-7026 (42862)
IN NAME OF

.....

Surveyed Aug. 19, 1983, by L. M. TOLL

PTS 1983-4