


# T.14S.,R.10W.,W.M.

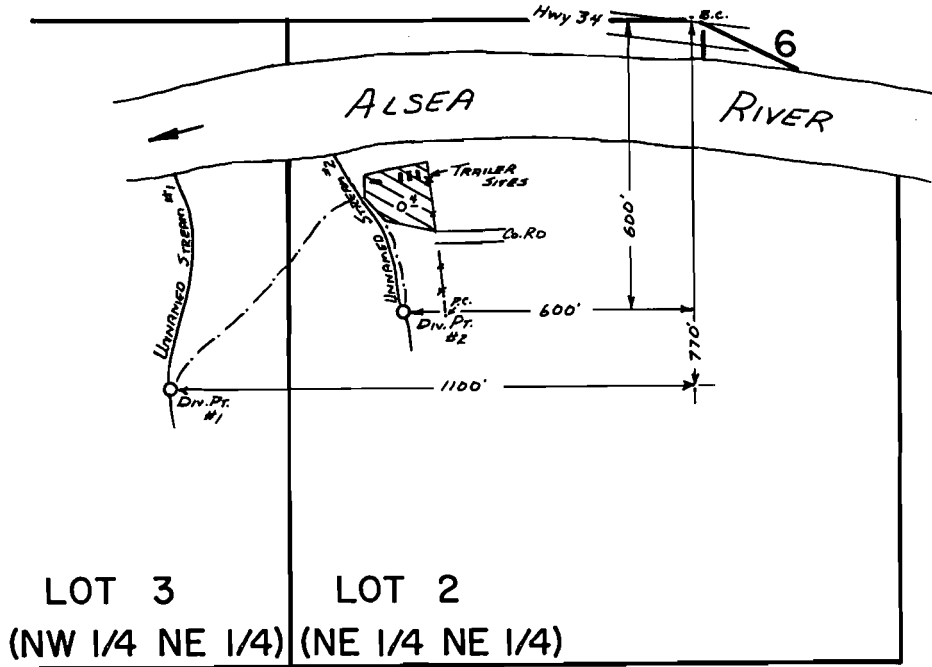

SCALE: 1" = 400'

## FINAL PROOF SURVEY UNDER

Application No. 56735 42571  
56962.. Permit No. 42909.....  
IN NAME OF

DELBERT J. MABE

Surveyed Oct. 21, 1981, by S.C. BROWN