


T.14S.,R.10W.,W.M.

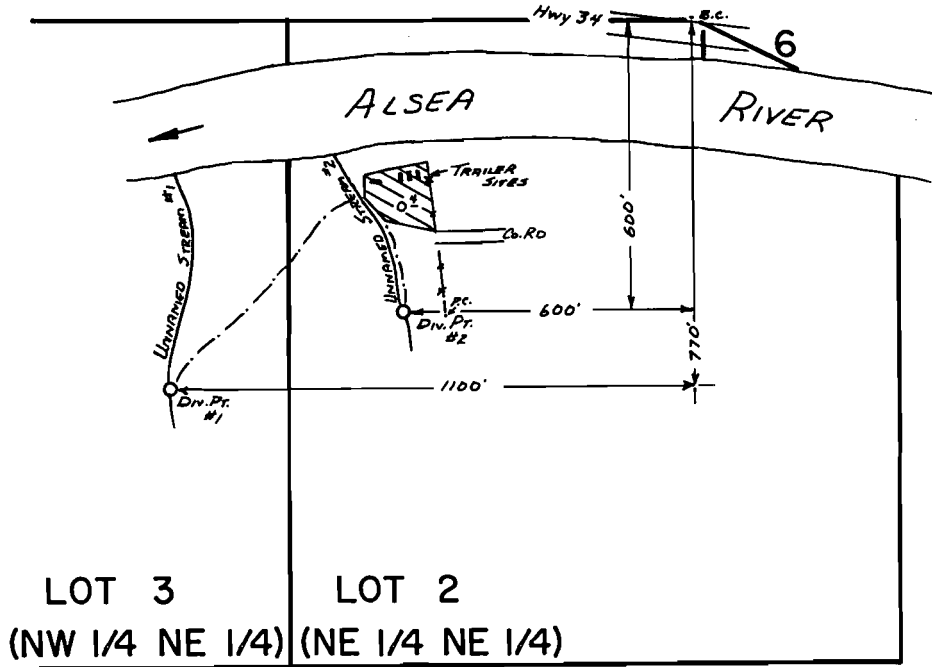

SCALE: 1" = 400'


FINAL PROOF SURVEY UNDER

Application No. 56735 Permit No. 42571
56962.. 42909.....
IN NAME OF

.....DELBERT J. MABE.....

Surveyed Oct. 21, 1981, by S.C. BROWN....

T.14S.,R.10W.,W.M.

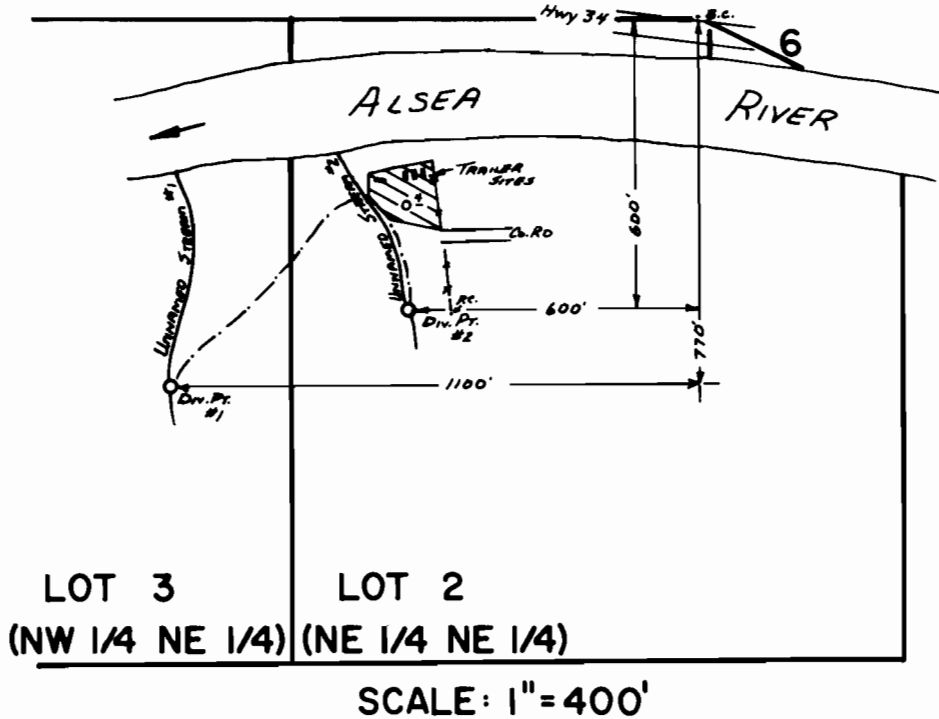

FINAL PROOF SURVEY UNDER

Application No. 56735 42571
 56962 Permit No. 42909.....
 IN NAME OF

...JOHN B. AND JEANELLE K. NORRIS...

Surveyed Oct. 21, 1981, by ...S. C. BROWN...