


T.7S R.5W W.M.

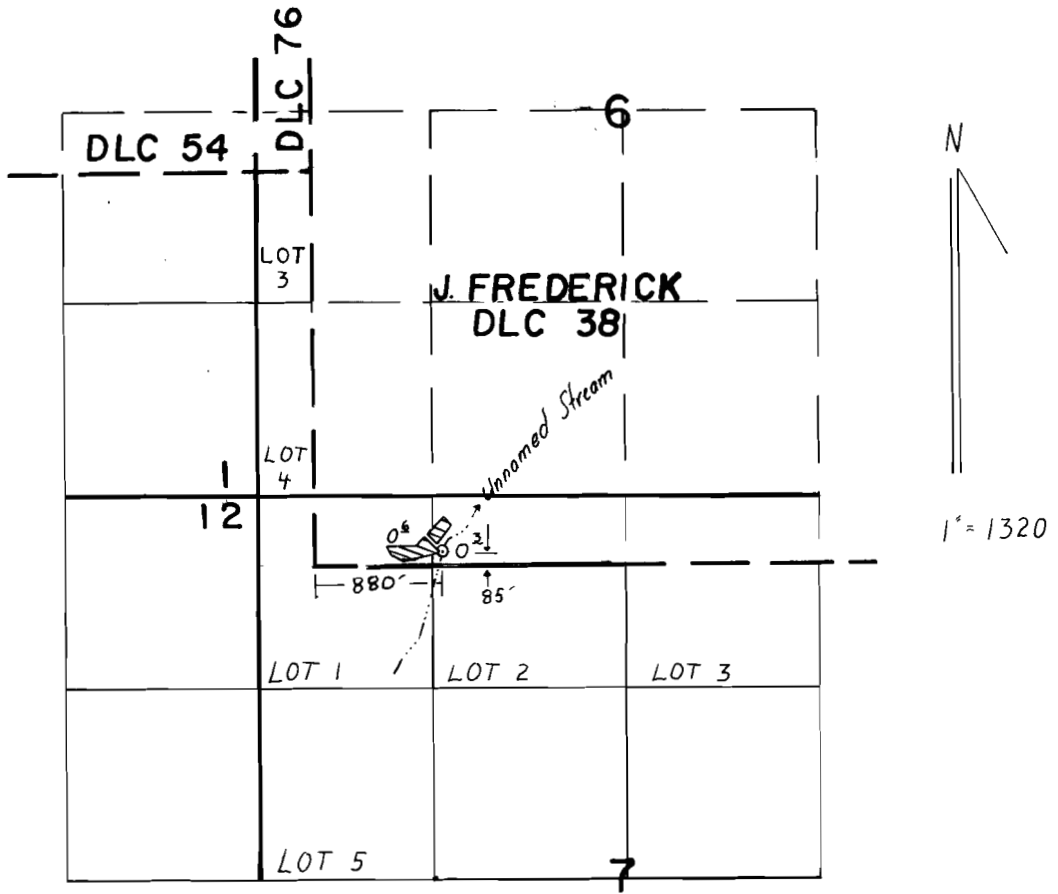

FINAL PROOF SURVEY UNDER

Application No. 56956 Permit No. 42702.....
IN NAME OF

RUBEN W. SCHELLENBERG.....

Surveyed MAR. 22 1988, by I.M. WARREN.....