
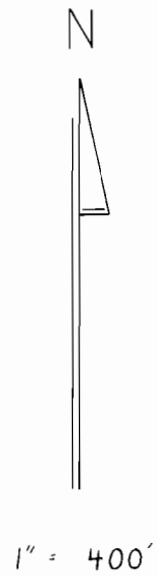


T5N, R7W, WM SEC 31

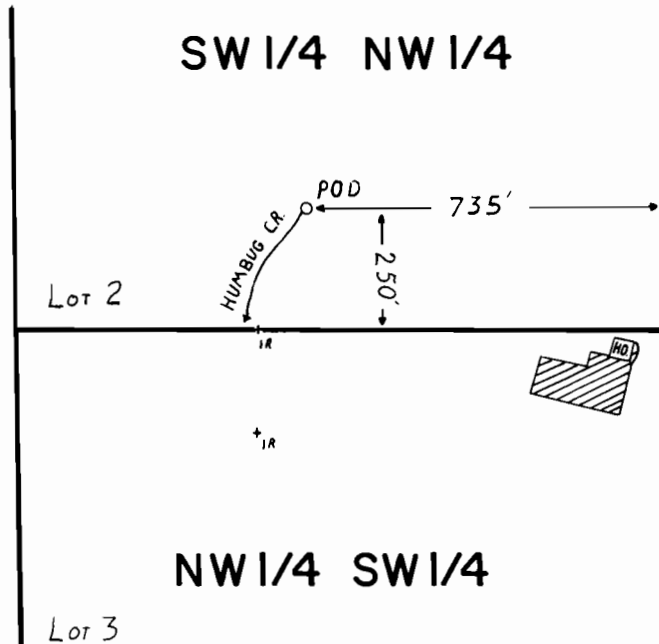

FINAL PROOF SURVEY UNDER

Application No. 57066. Permit No. 43201.....
IN NAME OF

EDWARD Q. & PATRICIA FAY WILSON

Surveyed AUG. 16. 1988, by I.M. WARREN....