



T. 7S., R. 38E. & 39E., W. M.

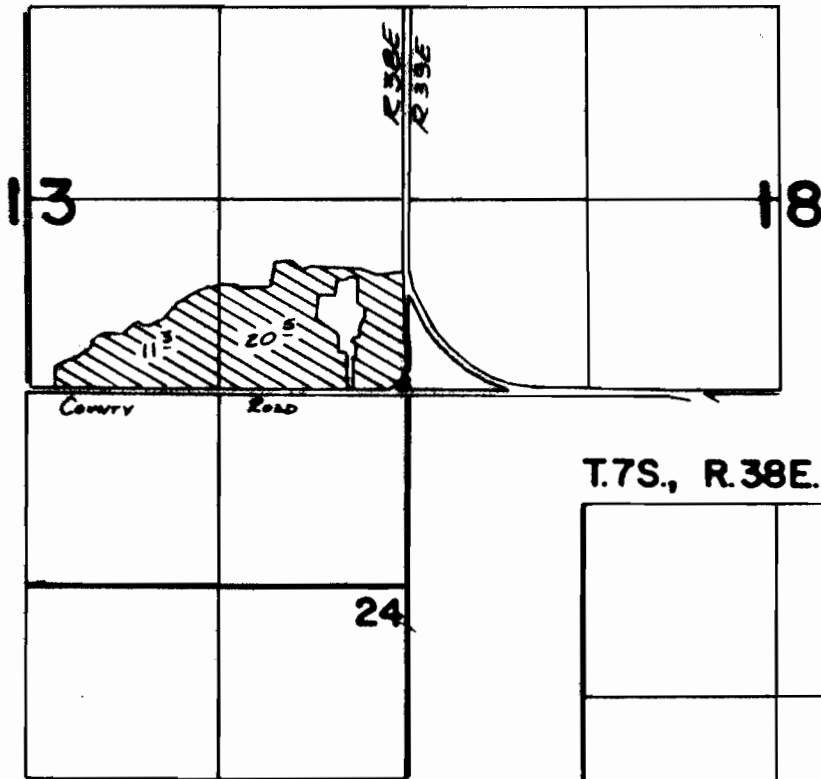

T. 7S., R. 38E., W. M.

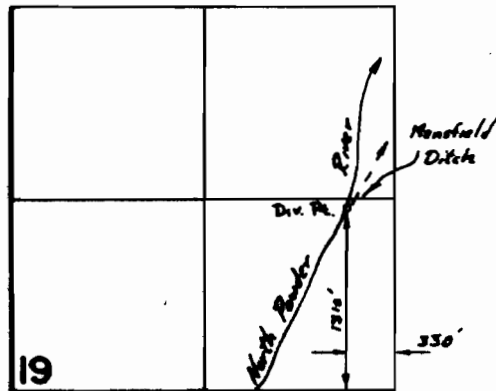

FINAL PROOF SURVEY
UNDER

Application No. **57156**.. Permit No. **43215**...
IN NAME OF

.....**RONALD D. PERKINS**.....

Surveyed **April 14**... 19**87**.. by **K. L. Church**.....