


P-43144
60620

T. 9S., R. 27E., W.M.

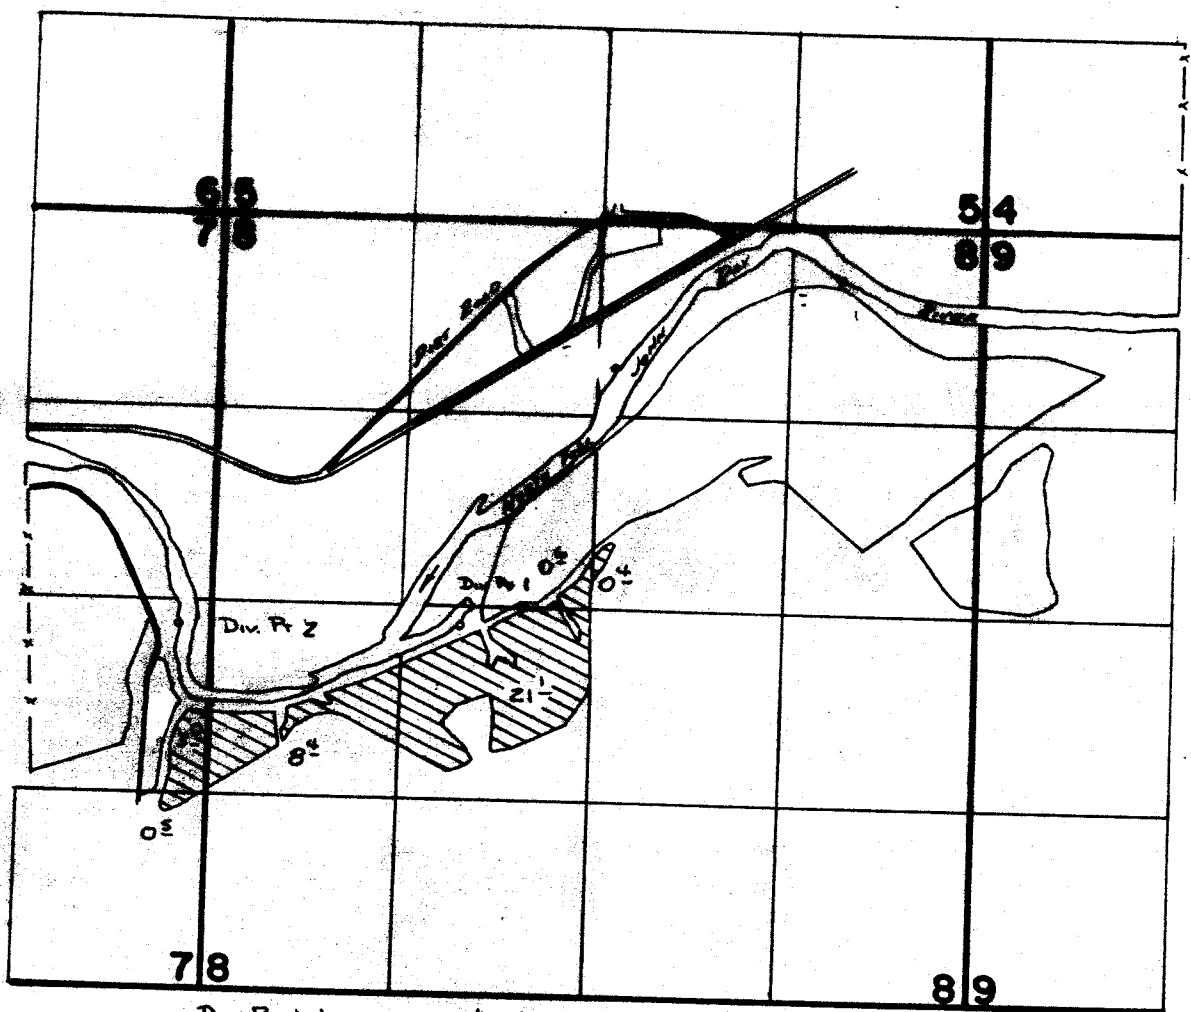

Div. Pt. 2 LOCATED 170'S. & 230'W. FROM EY4 COR. SEC. 7.
 Div. Pt. 1 LOCATED 130'S. & 1730'E. FROM WY4 COR. SEC. 8

FINAL PROOF SURVEY UNDER

Application No. **57193** Permit No. **43144**.....
 IN NAME OF

.....**WESTERN RIDGE LAND COMPANY**.....

Surveyed **2-4**..... 1985., by **V. L. Church**.....

SCALE 1" = 1320'