


T. 11 S., R. 5 W., W. M.

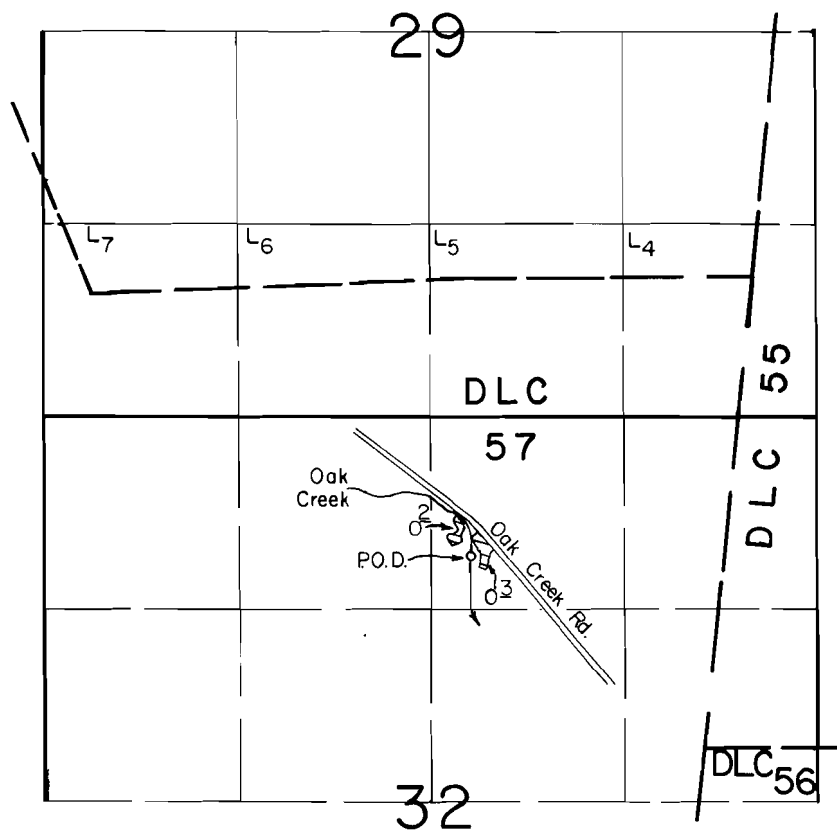

P.O.D. Loc. : 1680' N. & 280' E. from C. 1/4 Cor. Sec. 32.

Scale : 1" = 1320'

FINAL PROOF SURVEY
UNDER

Application No. 58726 Permit No. 44262
IN NAME OF

JAMES CRAIG McELDOWNEY

Surveyed Sept. 21, 1987, by T. Warren