


# T8N, R8W, WM SEC 27

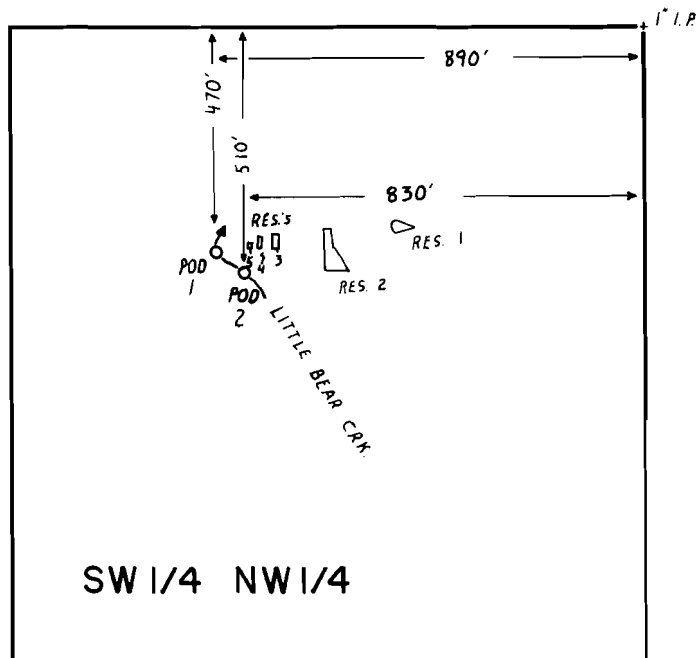

## FINAL PROOF SURVEY UNDER

R-58833 R-7931  
Application No. 58834 Permit No. 44399  
IN NAME OF

FREDERICK KOEHLER FARNER

Surveyed JULY 21, 1988, by T.M. WARREN