
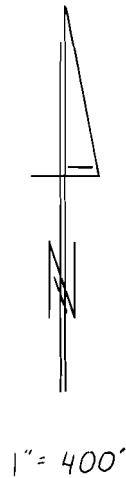


T8N, R8W, WM SEC 27

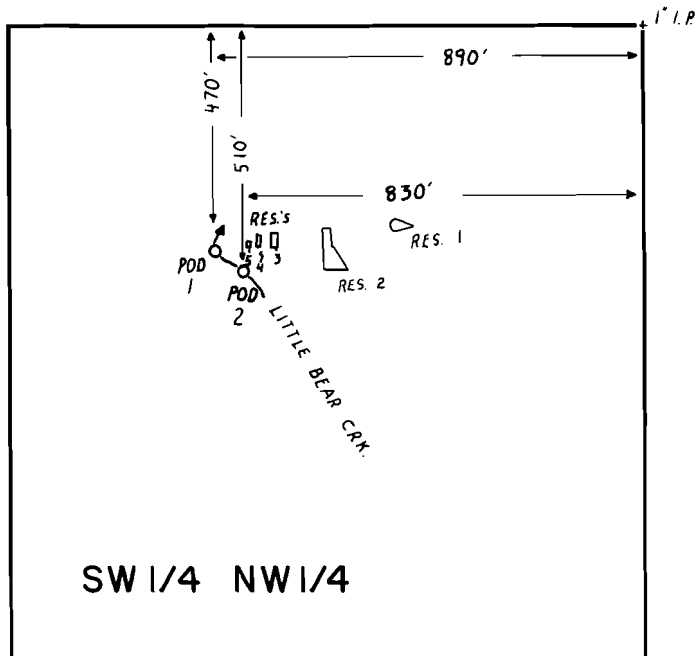

FINAL PROOF SURVEY UNDER

R-58833 R-7931
Application No. 58834 Permit No. 44399....
IN NAME OF

FREDERICK KOEHLER FARNER....

Surveyed JULY 21, 1988, by T.M. WARREN....