


T. 2 N., 4 W., W. M.

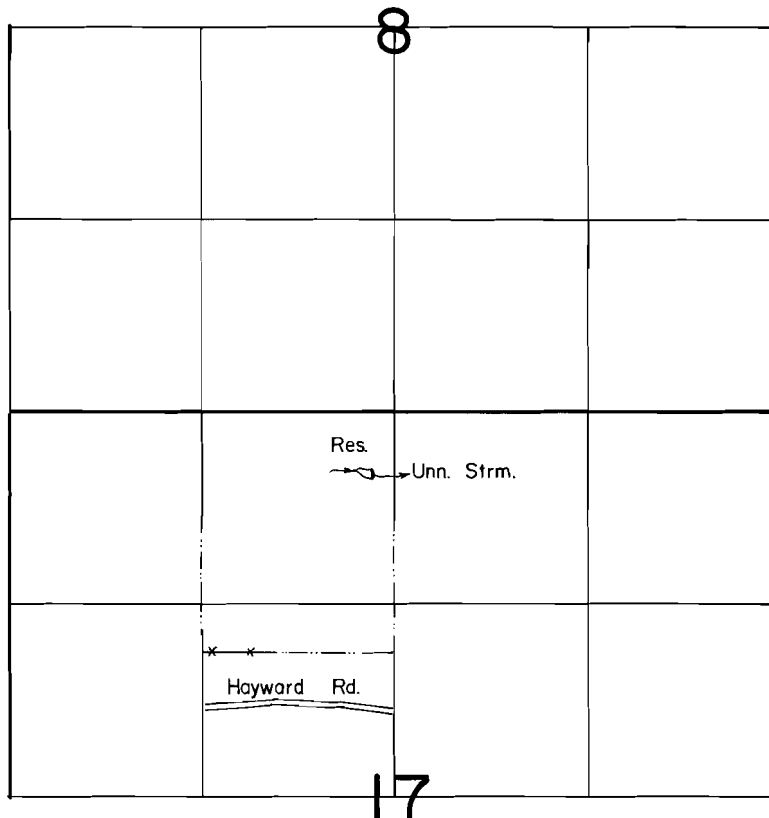

P.O.D. Loc. : 430' S. & 150' W. from N. 1/4 Cor. Sec. 17.

Scale : 1" = 1320'

FINAL PROOF SURVEY

UNDER

R-58934

R-8207

Application No. 59872 Permit No. 45347

IN NAME OF

ROBERT McCracken

Surveyed AUG. 10 1988, by T. Warren