


# T.25S., R.6W., W.M. Sections 29 and 32.

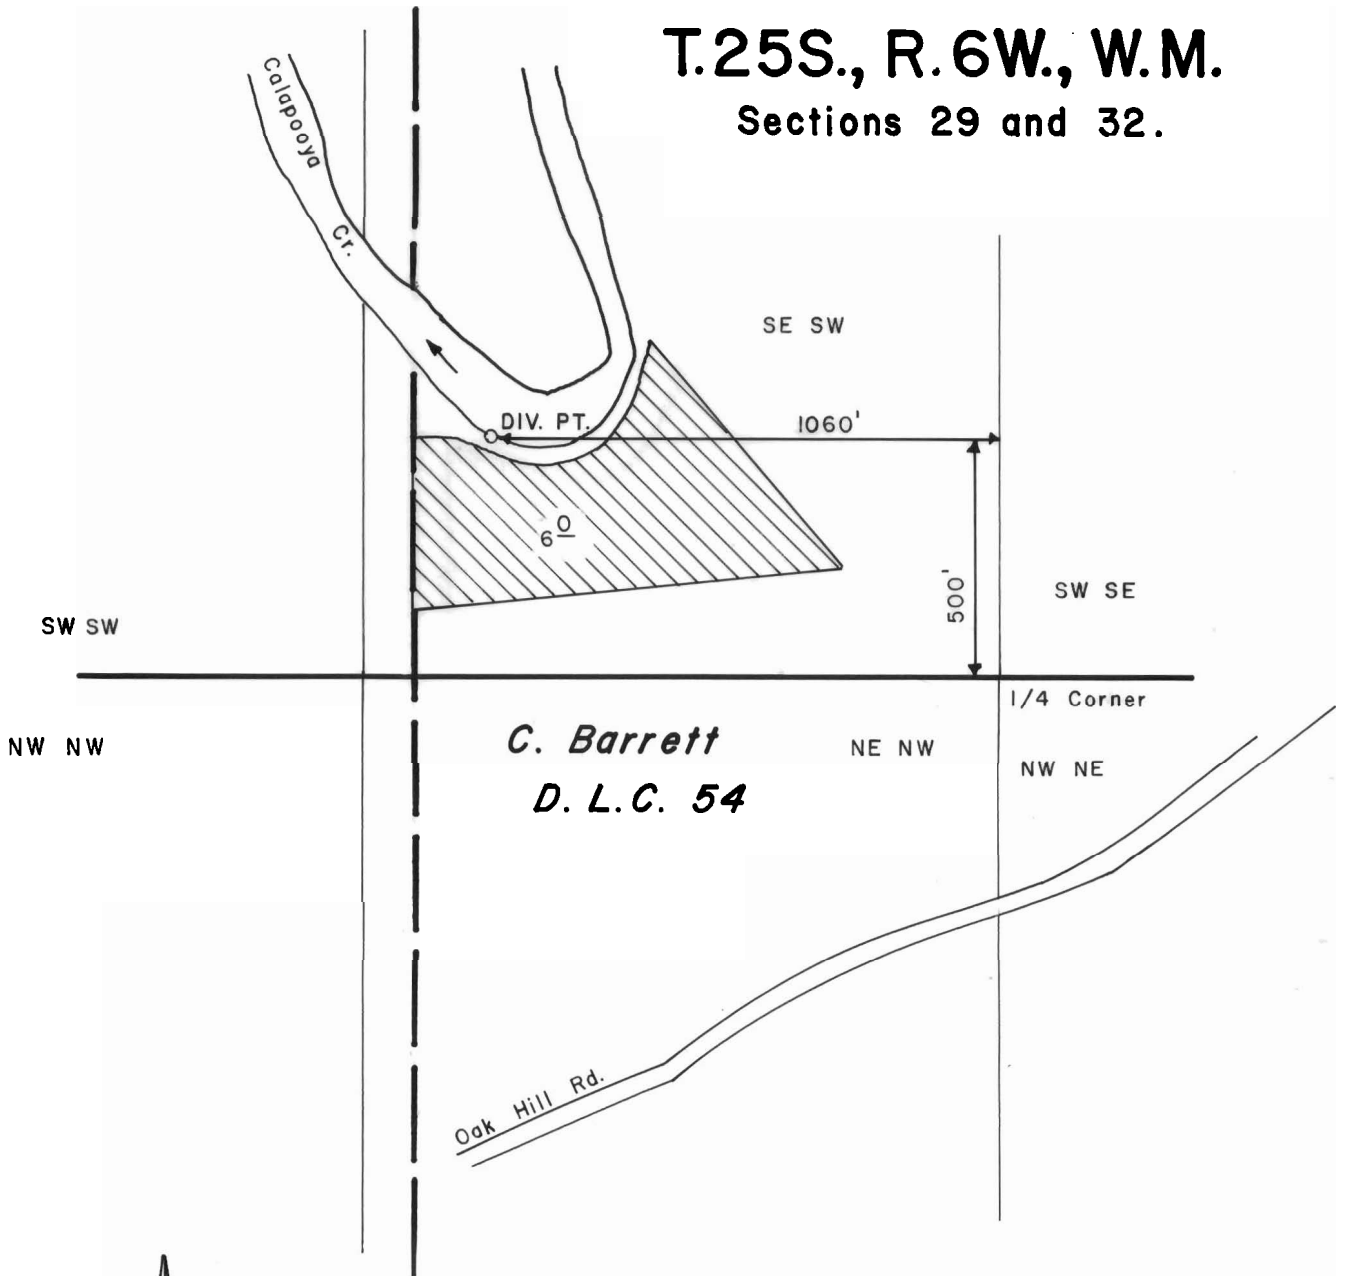

Scale: 1" = 400'



## FINAL PROOF SURVEY UNDER

Application No. 59421, Permit No. 44702  
IN NAME OF

**Frank Varnum**

Surveyed JULY 10 1986, by J. M. SCHMORDE