


T. 283N., R. 4W., W.M.

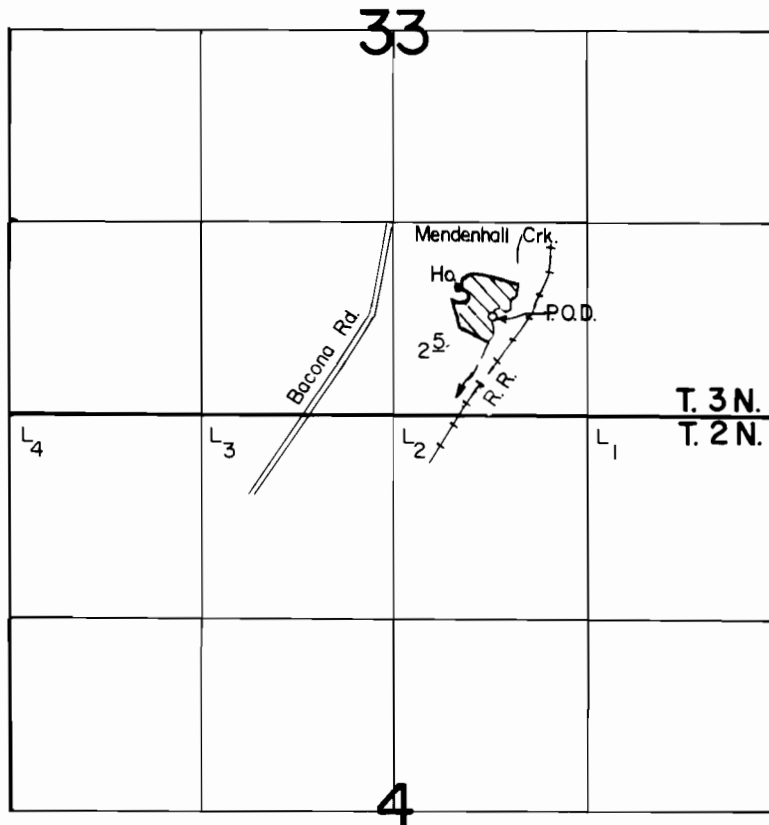

P.O.D. Loc.: 680' N. & 670' E. from S 1/4 Cor. Sec. 33.

Scale: 1" = 1320'

FINAL PROOF SURVEY

UNDER

Application No. 59684 Permit No. 44952
IN NAME OF

DANIEL LEE & SHARON ELAINE THOMPSON

Surveyed JUNE 23 1987, by Ben Bishop