


T.10S., R7W., W.M.

SEC. 12

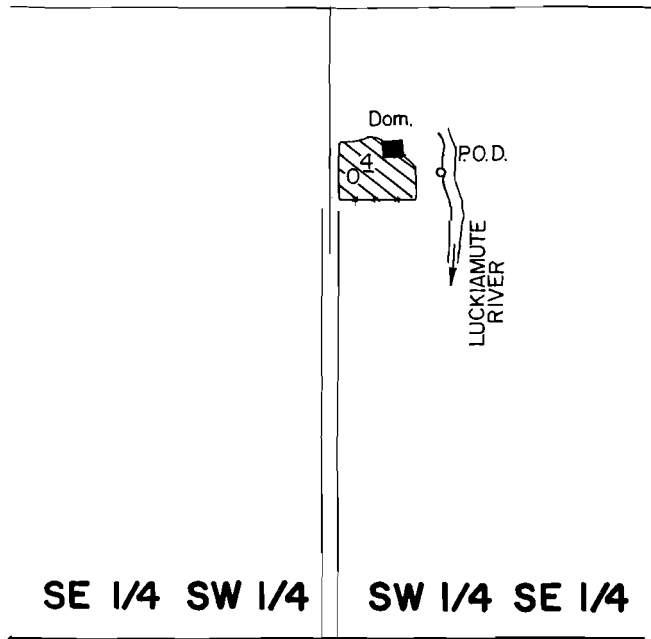

P.O.D. Loc.: 340' S. & 230' E. from NW Cor. SW 1/4 SE 1/4, Sec. 12.

Scale : 1" = 400'

FINAL PROOF SURVEY UNDER

Application No. 59886 Permit No. 44811
IN NAME OF

.....
Surveyed APRIL 30 1987, by T. Warren.....

PT5-1987 A
10/26/80 TMW