


# T9N, R7W, WM

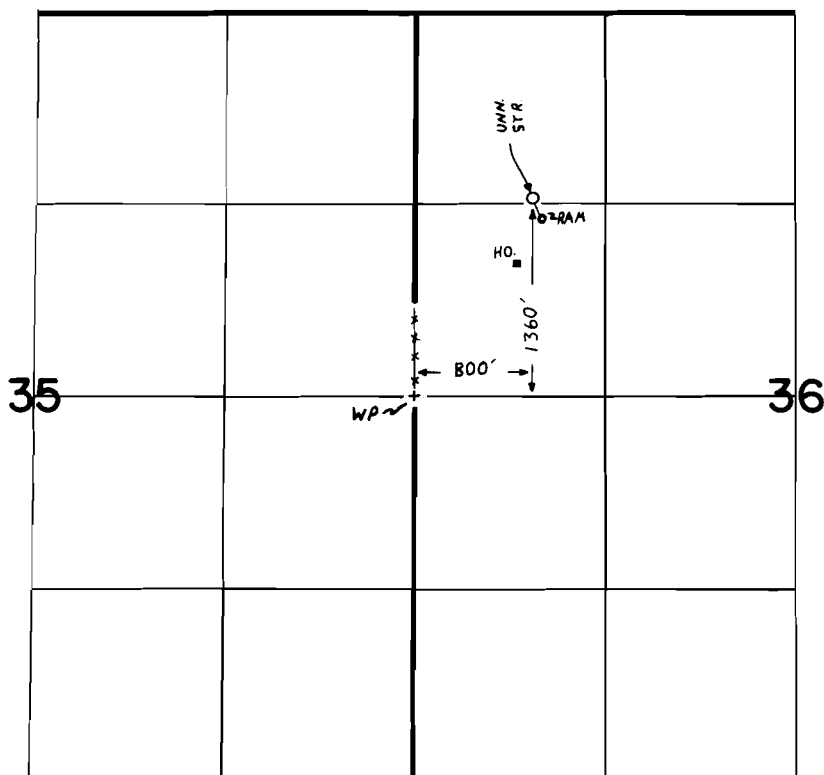

1" = 1320'

## FINAL PROOF SURVEY UNDER

Application No. 60070 Permit No. 45276  
IN NAME OF

DAN & TORY SUTHERLAND

Surveyed JULY 18 1988, by T.M. WARREN.