
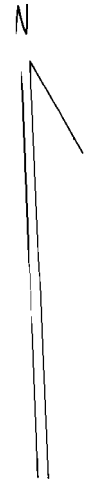


T10S, R7W, WM

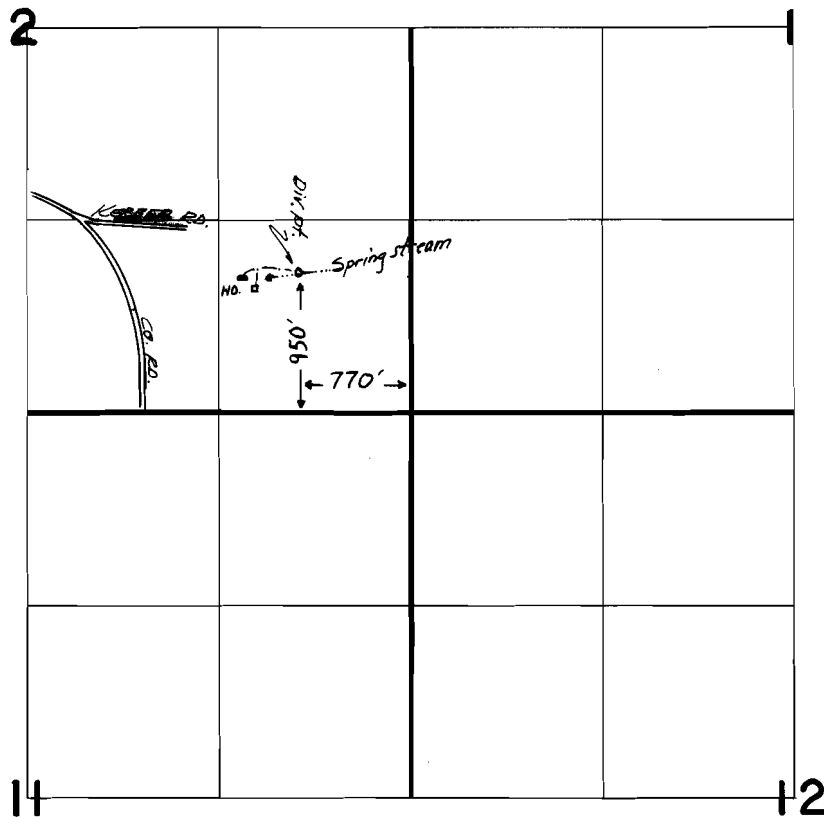

1" = 1320

FINAL PROOF SURVEY UNDER

Application No. 61589 Permit No. 45708
IN NAME OF

KEITH R. BARNHART

Surveyed MAR 24 1988, by T.M. WARREN

RWK

41053 178 123R