
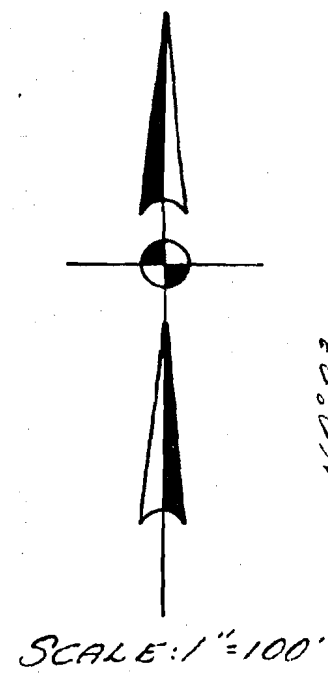


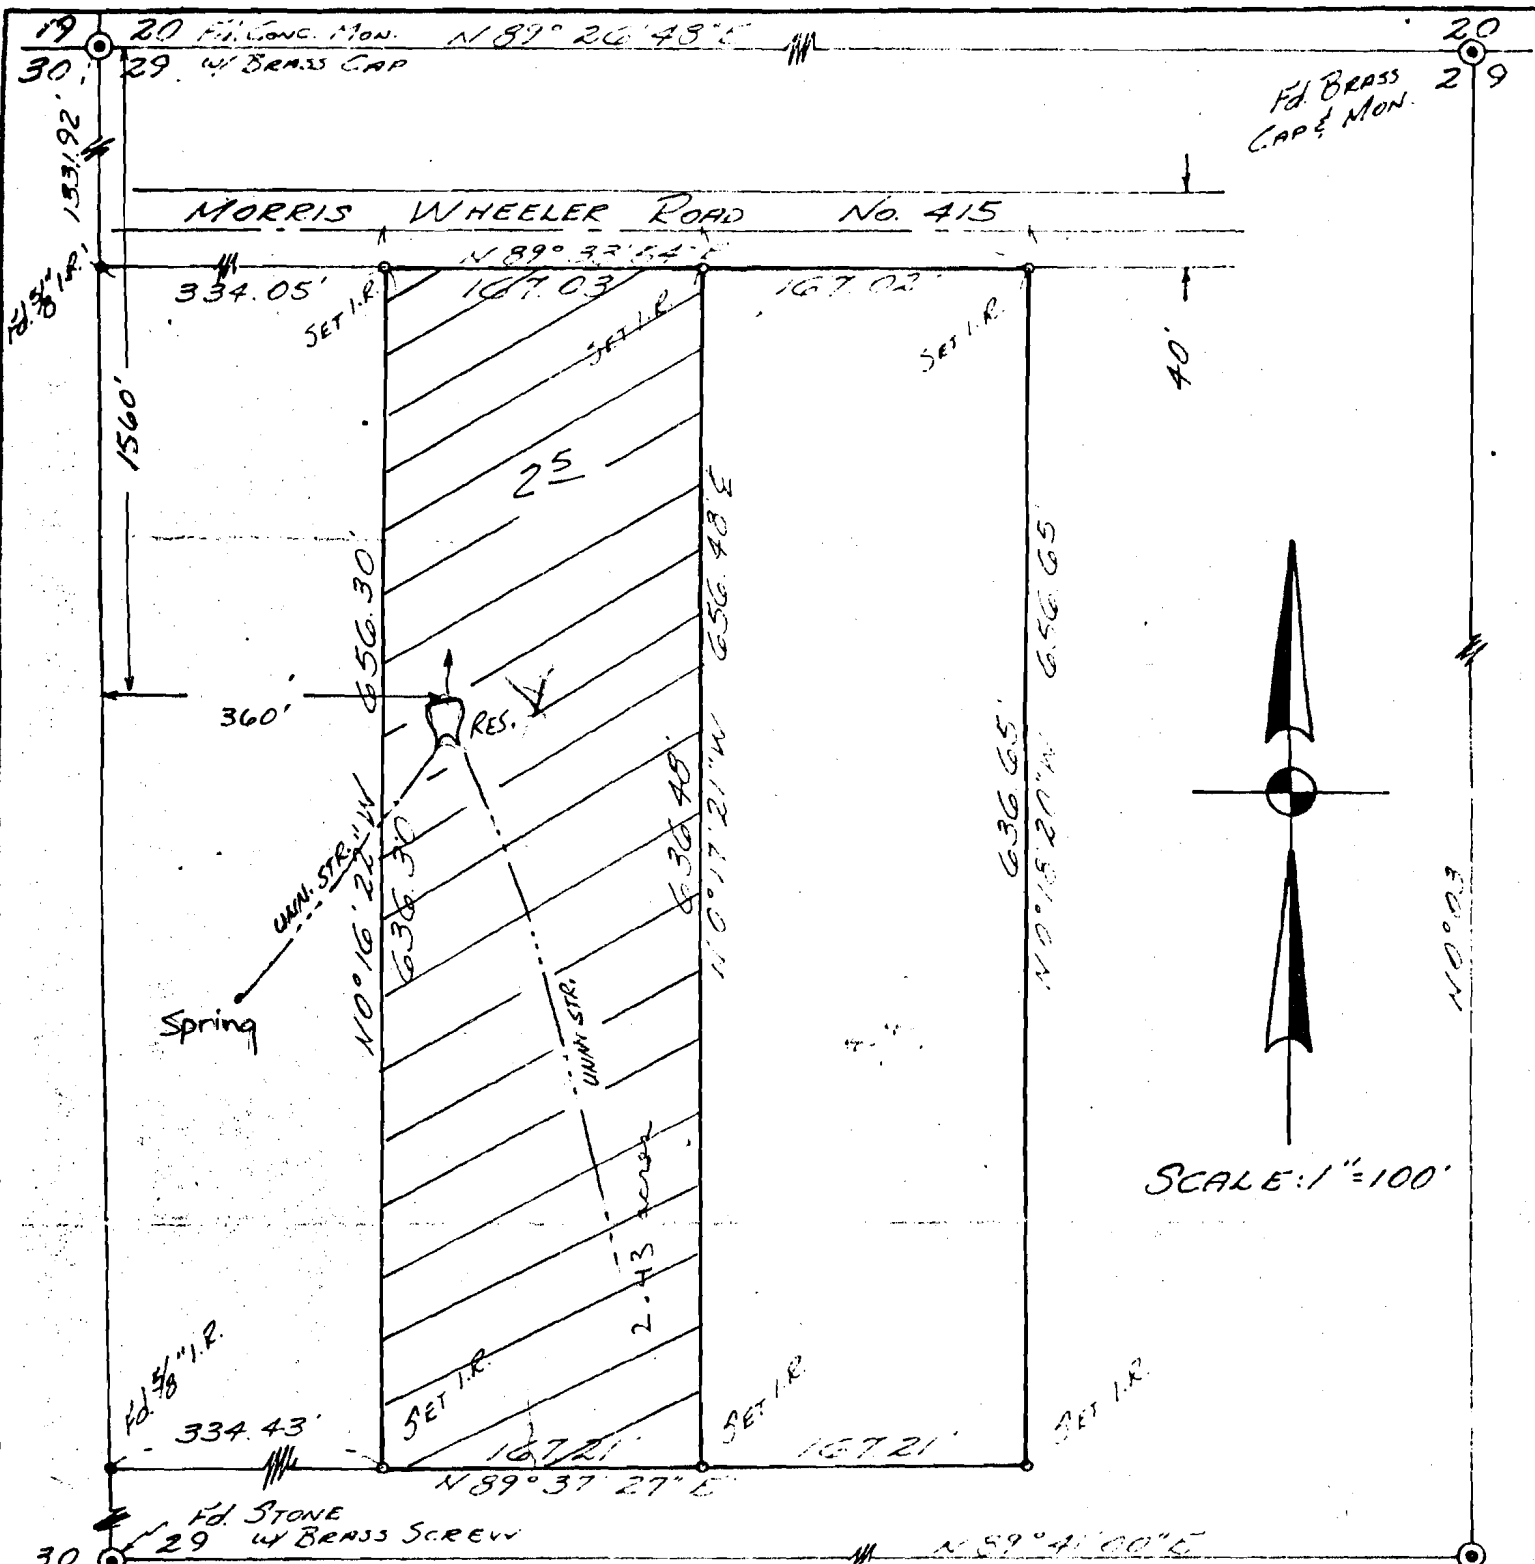

I hereby certify that this sketch is based upon an actual survey and that the property corners shown hereon are staked or referenced correctly on the ground as indicated by the following symbols:

Set 5/8"x30" Iron Rod.....o I.R.	Set 5/8"x30" Iron Rod.....o I.R.
Found iron pipe.....e	Brass screw.....x B.S.
Set " "e I.P.	Tack in lead.....x
Wood hub.....□	Conc. monument.....●

BASIS OF BEARINGS:
 MARK & CHASE
 SURVEY 66-460

Application No. 61546 R-61545
 Permit No. 46562 R 8378

PROPERTY SURVEY

SUBDIVISION OF NW 1/4 SW 1/4 NW 1/4 OF