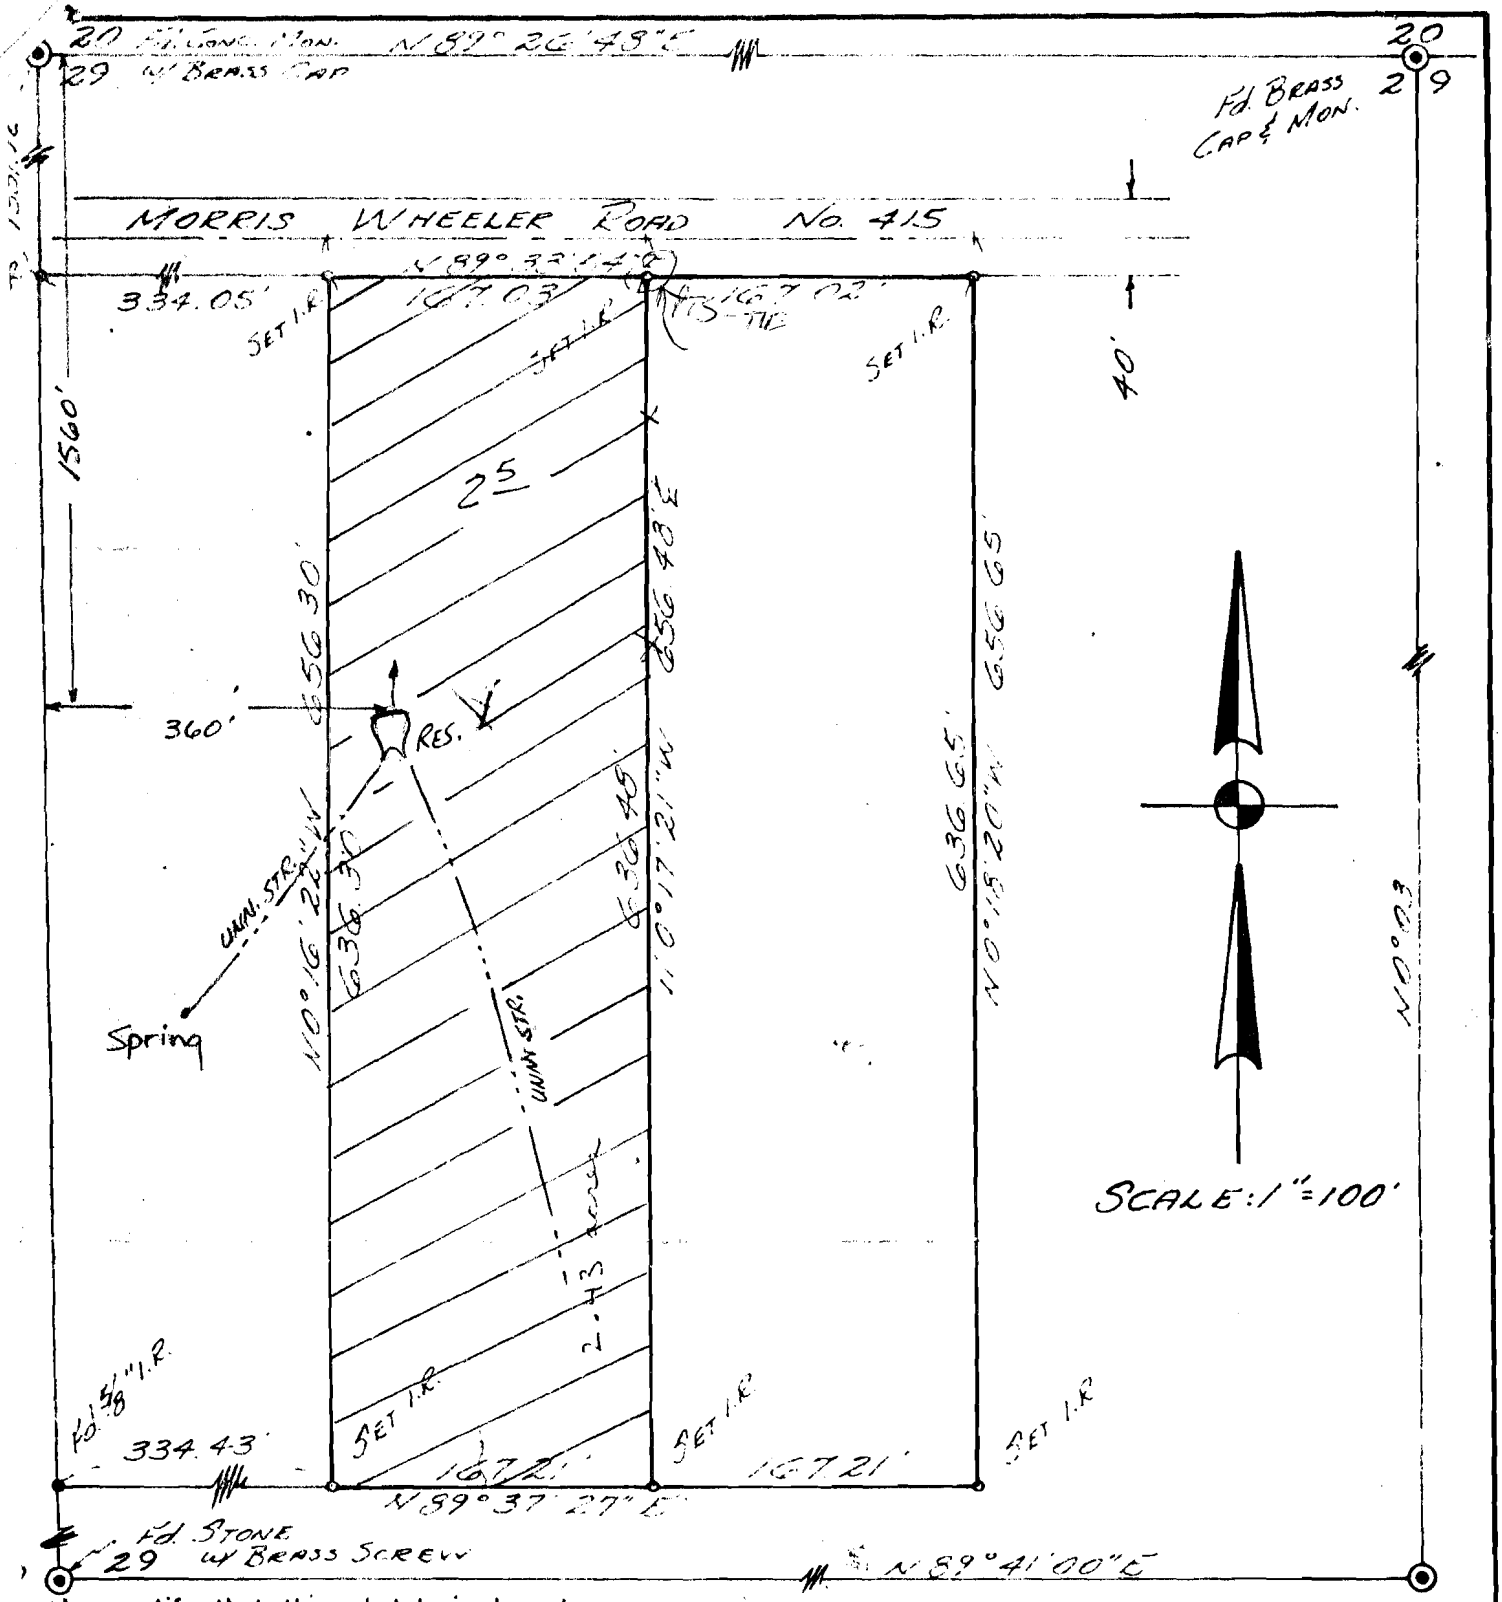


ereby certify that this sketch is based
n on actual survey and that the property
ners shown hereon are staked or referenced
rectly on the ground as indicated by the
owing symbols:
nd iron pipe.....●
" "● I.P.
od hub□
Set 5/8"x 30" Iron Rod.....o I.R.
Brass screw ⊗ B.S.
Tack in lead ✕
Conc. monument..... ◎

BASIS OF BEARINGS:
MARX & CHASE
SURVEY 66-460

Application No. 46562 615-16 & R-61545 R 8378